

HOUSING COMMUNITY & DEVELOPMENT DEPARTMENT
PERMITS & INSPECTIONS DIVISION

Record Set to Helen mif

CONDEMNATION OF BUILDINGS


WORK SHEET

ADDRESS 1313 Harney STRUCTURE Brk Ord
TYPE Com. Bldg. Parking Gar. SIZE 132x132x20
BASEMENT No STORIES 1
OCCUPANT _____

1405 03 CONDITION OF BUILDING: Possible Impact Damage E. side

LOCATION: SHOW LOCATION OF STRUCTURE ON THE PLATTED BLOCK AS MEASURED FROM CENTER LINES OF STREETS TO CENTER LINE OF STRUCTURE.

NOTICE OF PLACING

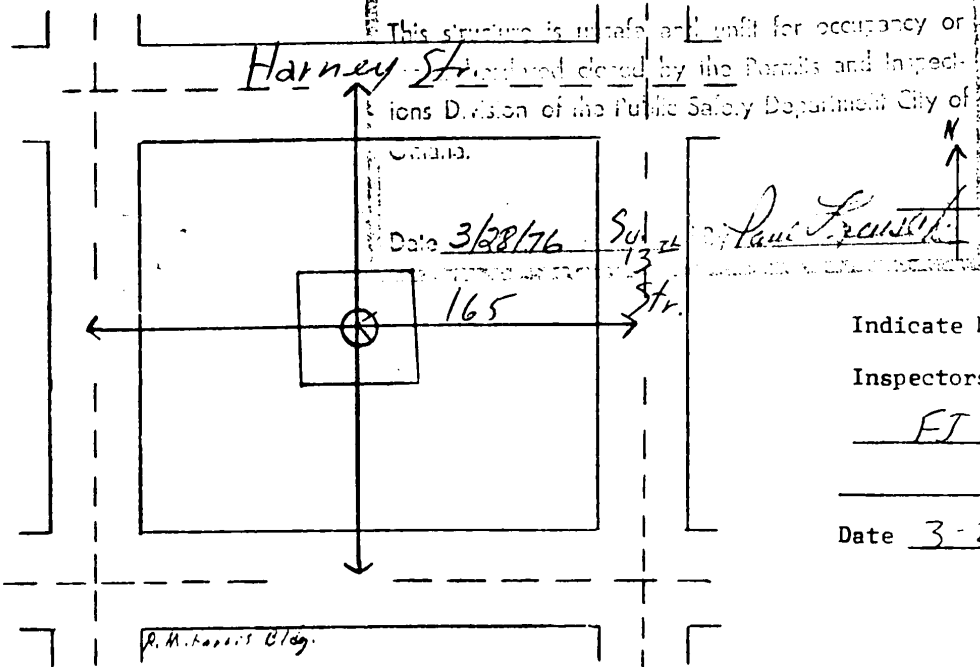

Indicate North.

Inspectors: FJZ

Date 3-24-77

LEGAL DESCRIPTION Lts 2 + 3 B149 City Lots

OWNER: Kennedy-Pritchett Co. (Breakdown of ownership attached)

ADDRESS: % Byron-Reed Co. - 600 Continental Bldg

BPI-164 OS *e.c. Charles B. Leib*
% Res Agent - Edwin Casson
400 City National Bank Bldg -

* Also owns L1

30

RECEIVED
1977 MAR 28 AM 11:54
C. HAROLD OSTLER
REGISTER OF DEEDS
DOUGLAS COUNTY, NEBR.

Book 578
Page 532
of 5
Fee 20.00
Index 15-6
Comped 9-57