



2004-01906A

WARNING: THIS DRAWING CANNOT BE LEGALLY USED TO INSTALL A FENCE OR ANY OTHER STRUCTURE ON THIS PROPERTY, AND IS NOT INTENDED TO BE A LAND SURVEY AS DEFINED BY STATE STATUTES.

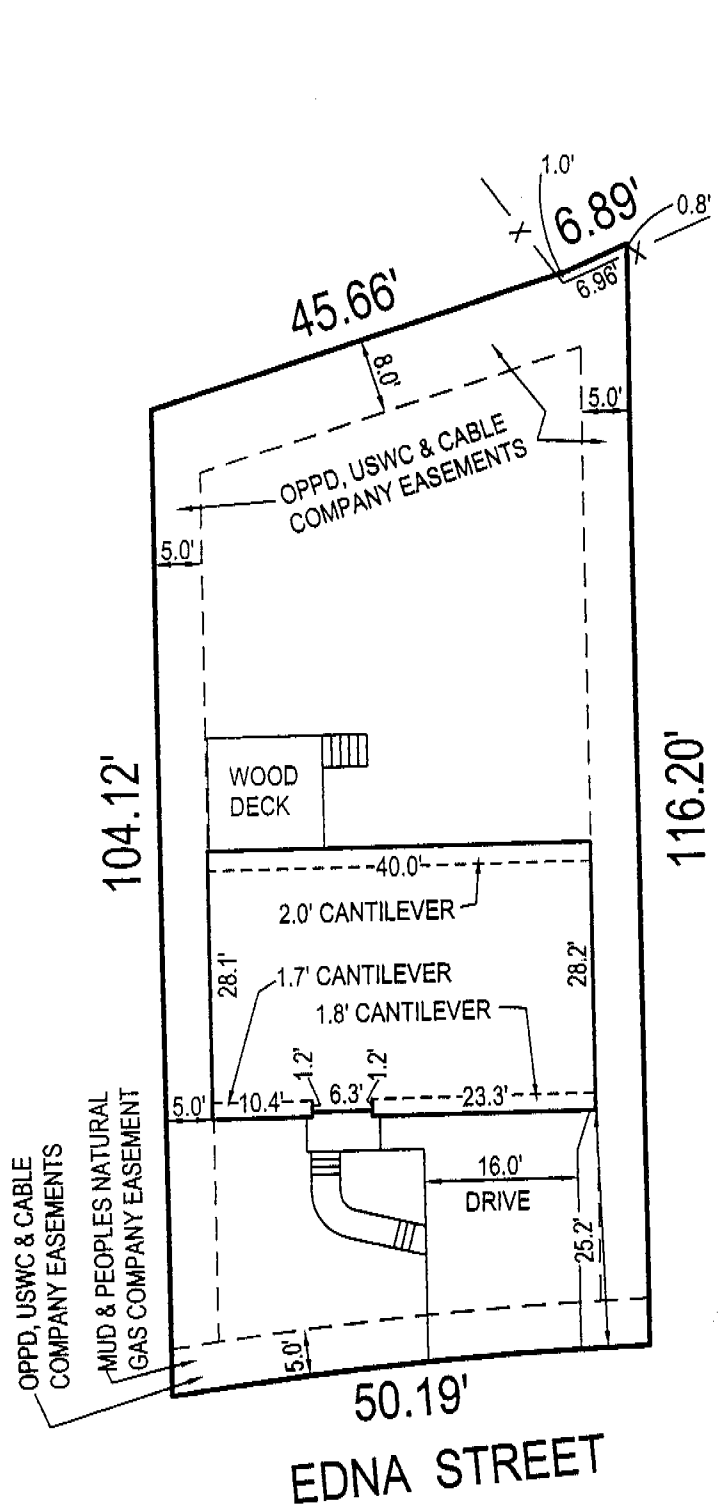

Scale: 1" = 20'

EDNA STREET

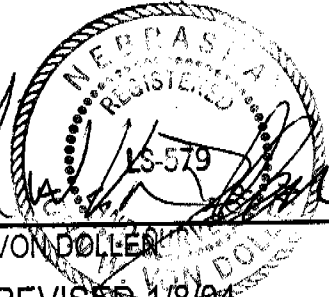
 JOHN W. VONDOLLEN L.S. 579
 12-8-03 REVISED 1/8/04
 DATE



E&A CONSULTING GROUP, INC.
 ENGINEERS • PLANNERS • SURVEYORS
 12001 Q STREET OMAHA, NE 68137 PHONE: (402) 895-4700

HOUSE STAKE BOOK: 2546, PAGE 56
 AS BUILT BOOK: 2659, PAGE 27

Drawn by: SNV Chkd by: *JS* Date: 1/9/04 Chkd by: Date:
 Job No.: 98200 Date: 12-10-03 Client Job No.: hkr04/492/0000

AS BUILT SURVEY
 LOT 492
 HICKORY RIDGE
 17714 EDNA STREET