

1134 058 MISC

13572 84 058-098

11/11/84

Return: N.L. FA.
11313 Davenport
Omaha, Ne 68115


AS BUILT SURVEY

PART OF LOT 1, HIDDEN RIDGE

AND PART OF LOT 1, WESTERN TRAILS II REPLAT I

16518 ARBOR STREET

Survey
R.S.H.

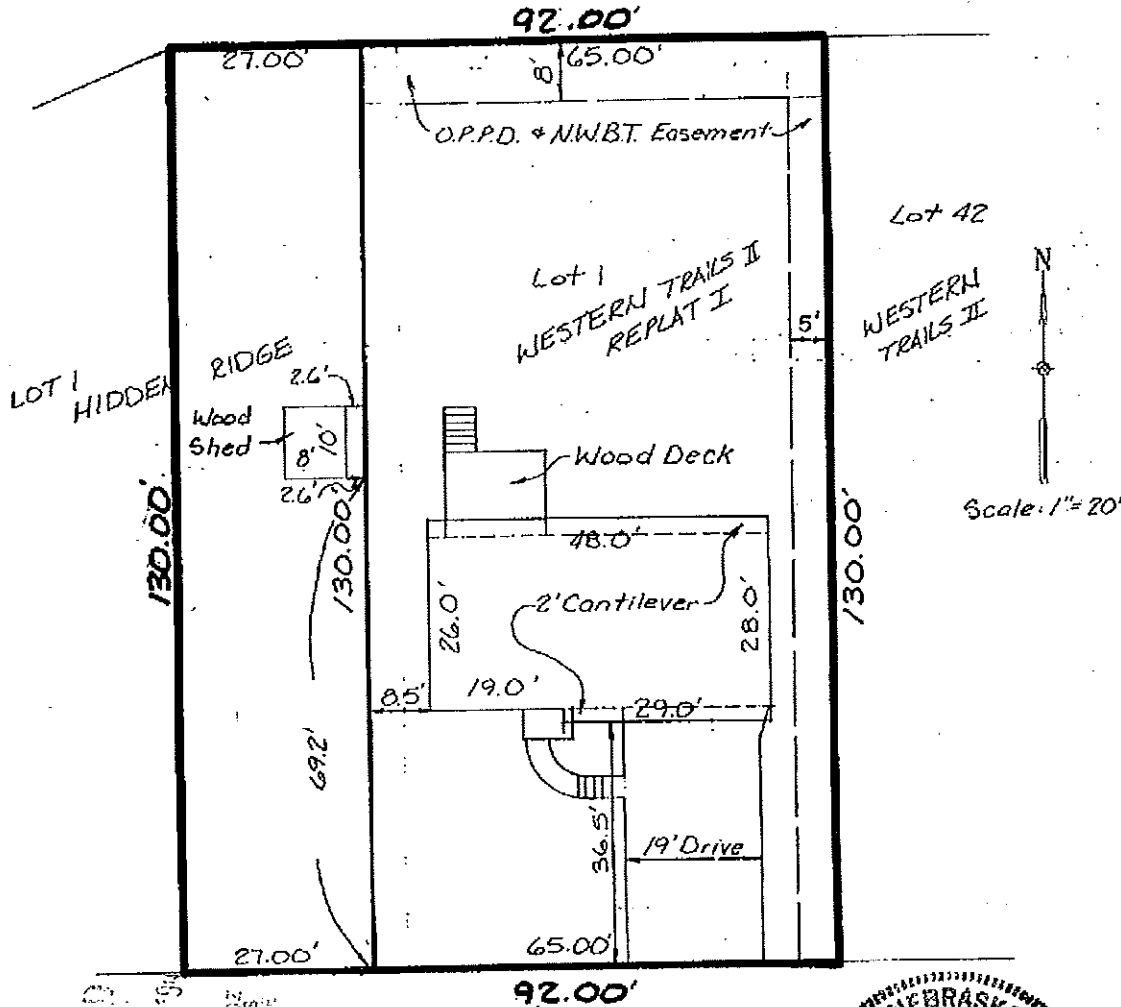


Lot 42
 WESTERN TRAILS II



Scale: 1" = 20'

ARBOR STREET

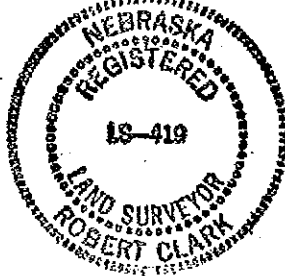

Robert Clark
 Robert Clark L.S. 419
 10-4-94
 Date

RECORDED
 NOV 18 1 02 PM '94
 13572

MI-43373
 MI-10223 780#

FILE	11-30	11	10-1-24 NEW
DEL.	11	CCMP	11
LEADERS			

2795

#92041
 BK 887

