

\$26750

BLOCK

CODE

CHECKED

ENTERED

EDITED

Dan Galt

REGISTER OF DEEDS

2001 NOV 16 A 9:44

LANCASTER COUNTY, NE

INST. NO 2001

067989

GRANTEE COUNTERPART

(Lancaster County, Nebraska)

C.D. No. 54775-8

Audit No. 154693

PERPETUAL EASEMENT DEED

THIS EASEMENT DEED, made as of the 24th day of August, 2001, by UNION PACIFIC RAILROAD COMPANY, a Delaware corporation, whose mailing address is 1416 Dodge Street, Omaha, Nebraska 68179 ("Grantor"), to MCI WORLDCOM NETWORK SERVICES, INC. (formerly MCI Telecommunications Corporation), a Delaware corporation, whose mailing address is 2270 Lakeside Blvd., Richardson, Texas 75082 ("Grantee")

WITNESSETH:

WHEREAS, Grantor and Grantee have entered into an Agreement dated as of March 11, 1985, and an Amendment To And Restatement Of Agreement dated as of August 28, 1989 (said agreements, as the same have been and may hereafter be amended and restated from time to time, hereinafter, collectively, the "Agreements"), whereby Grantor has granted to Grantee the right to construct, operate and maintain a Fiber System (hereinafter defined on certain property of Grantor included within its main line railroad right-of-way located in Lancaster County, Nebraska (hereinafter, the "Right-of-Way"), under the terms, provisions, and conditions contained in the Agreements, one of which is that Grantor shall grant to Grantee a perpetual easement in the form of this deed.

NOW, THEREFORE, for and in consideration of Ten Dollars (\$10.00), the receipt of which is hereby acknowledged, and for other good and valuable consideration, Grantor by these presents does hereby grant to Grantee a PERPETUAL EASEMENT located within the Right-of-Way as described on sheets 21 to 66 of Exhibit A attached hereto and made a part hereof, to construct, reconstruct, rebuild, reinstall, operate and maintain the fiber optic communications system ("Fiber System"), together with reasonable ingress and egress to and from the location of the Fiber System for the purpose of constructing, reconstructing, rebuilding, reinstalling, operating and maintaining the Fiber System. The Fiber System Cable is marked by markers or signs placed on the surface above the buried fiber optic cable approximately every 500 feet and by a buried tape placed approximately one foot above the Fiber System cable, such markers and tape being inscribed with the letters "MCI".

The Fiber System is or shall be located (or relocated pursuant to Section 12 of the Fiber Optic Agreement) only within and under, on, over and across that portion of the Right-of-Way as shall have been or shall hereafter be approved by Grantor in accordance with the terms and conditions of the Agreement.

*Rich Moyer
Worldcom
see reverse*

Except as hereinafter provided, in the event of a relocation pursuant to Section 12 of the Agreement of all or any portion of the Fiber System to any alternate location within Grantor's Right-of-Way, Grantor shall, after such relocation is effected, execute a Perpetual Easement Deed in a form similar to this Deed for such relocated Fiber System. In the event the relocation is required by Grantor, the rights granted for the relocated Fiber System shall, to the extent possible, be (1) equivalent in all respects to the rights granted herein, and (2) superior to any rights or interests granted subsequent to the date hereof. If the relocation is at the request of Grantee, Grantor shall, if such a location is reasonably available within Grantor's Right-of-Way, permit Grantee to relocate the Fiber System so that it shall be equivalent in all respects to the rights granted herein, except that it shall be subordinate to any rights or interests granted subsequent to the date hereof.

SUBJECT TO and RESERVING unto the Grantor, its successors and assigns, the following:

a. The foregoing grants are made without covenant of title or for quiet enjoyment and without warranty of title express or implied, and are subject and subordinate to outstanding or superior rights;

b. The foregoing grants are also subject and subordinate to the prior and continuing right and obligation of Grantor to use and maintain its entire property in the performance of its public duty as a common carrier and are also subject to the right and power of Grantor to construct, maintain, repair, renew, use, operate, change, modify or relocate railroad tracks, signal, communication or other wire or fiber lines, pipe lines and other facilities upon, along or across any or all parts of the Grantor's property, or permit others to do so for Grantor, all or any of which may be freely done at any time or times by Grantor or others with its permission without liability to Grantee or to any other party for compensation or damages, unless and except to the extent that the foregoing Agreement otherwise expressly provides;

c. The foregoing grants are non-exclusive and Grantor reserves the right to agree to other non-exclusive occupations of the easement area by one or more other person(s); PROVIDED, HOWEVER, that any such subsequent occupancies or agreements for such occupancies shall be subordinate to the rights granted herein to Grantee if Grantee has not relocated therefrom; and

d. The foregoing grants are also subject to all other terms, provisions and conditions contained in the aforesaid Agreement.

Grantor acknowledges and agrees that the Fiber System, including all movables and immovables, and all component parts thereof (and including, without limitation, those parts described in Exhibit B annexed hereto and made a part hereof), shall at all times be and remain personal property regardless of whether the same is permanently attached to the ground, and regardless of the manner or mode of

installation thereof; and the installation thereof shall not affect Grantee's (or its successors' or assigns') title thereto.

IN WITNESS WHEREOF, the Grantor has caused these presents to be signed by its Vice President – Law and attested by its Assistant Secretary and its corporate seal to be hereunto affixed as of the day and year first herein written.

UNION PACIFIC RAILROAD COMPANY

Attest:

By:

Title:

James V. Dole
Vice President - Law

[Signature]
Assistant Secretary

SEAL

ACKNOWLEDGMENT

STATE OF NEBRASKA)
) ss:
COUNTY OF DOUGLAS)

The foregoing instrument was acknowledged on this 29th day of August, 2001, before me, a Notary Public, duly commissioned, qualified and acting, within and for the said county and state, by JAMES V. DOLAN, to me personally known, who stated that he had signed, executed and delivered said foregoing instrument for the consideration, uses and purposes therein mentioned and set forth.

Sheryl L. Alvey
Notary Public

My Commission expires:


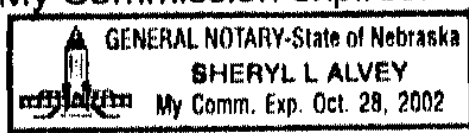


EXHIBIT "B" TO PERPETUAL EASEMENT DEED
MADE BY UNION PACIFIC RAILROAD COMPANY,
AS GRANTOR, TO MCI WORLDCOM NETWORK SERVICES, INC.,
AS GRANTEE

The Fiber System includes, without limitation, all fiber optic cable enclosing optical fibers designed to carry lightwaves in a fiber-optic lightwave telecommunications system ("Fiber-Optic Cable"); physical devices used to support a Fiber-Optic Cable which is not buried; pvc or metal pipe, and/or flexible plastic interduct tubing within such a pipe, in which pipe or tubing Fiber-Optic cable is encased; steel or pre-cast concrete boxes housing splices of Fiber-Optic Cable; modular structures; buildings and other constructions permanently attached to the ground; the contents of such structures, buildings and other constructions, including, without limitation, climate control equipment, light fixtures, wiring, transmitting devices and receiving devices that transform electrical energy into light or vice versa, racks for electronics and other equipment, fault alarm equipment, order wire, test equipment, batteries and electric power test equipment; all markers or signs placed on the surface above buried Fiber-Optic Cable and the buried tape placed above Fiber-Optic Cable; and all additions, replacements, alterations and substitutions to the Fiber System as may from time to time occur.

R/L CHS. IS
PARALLEL U.P.-R.R

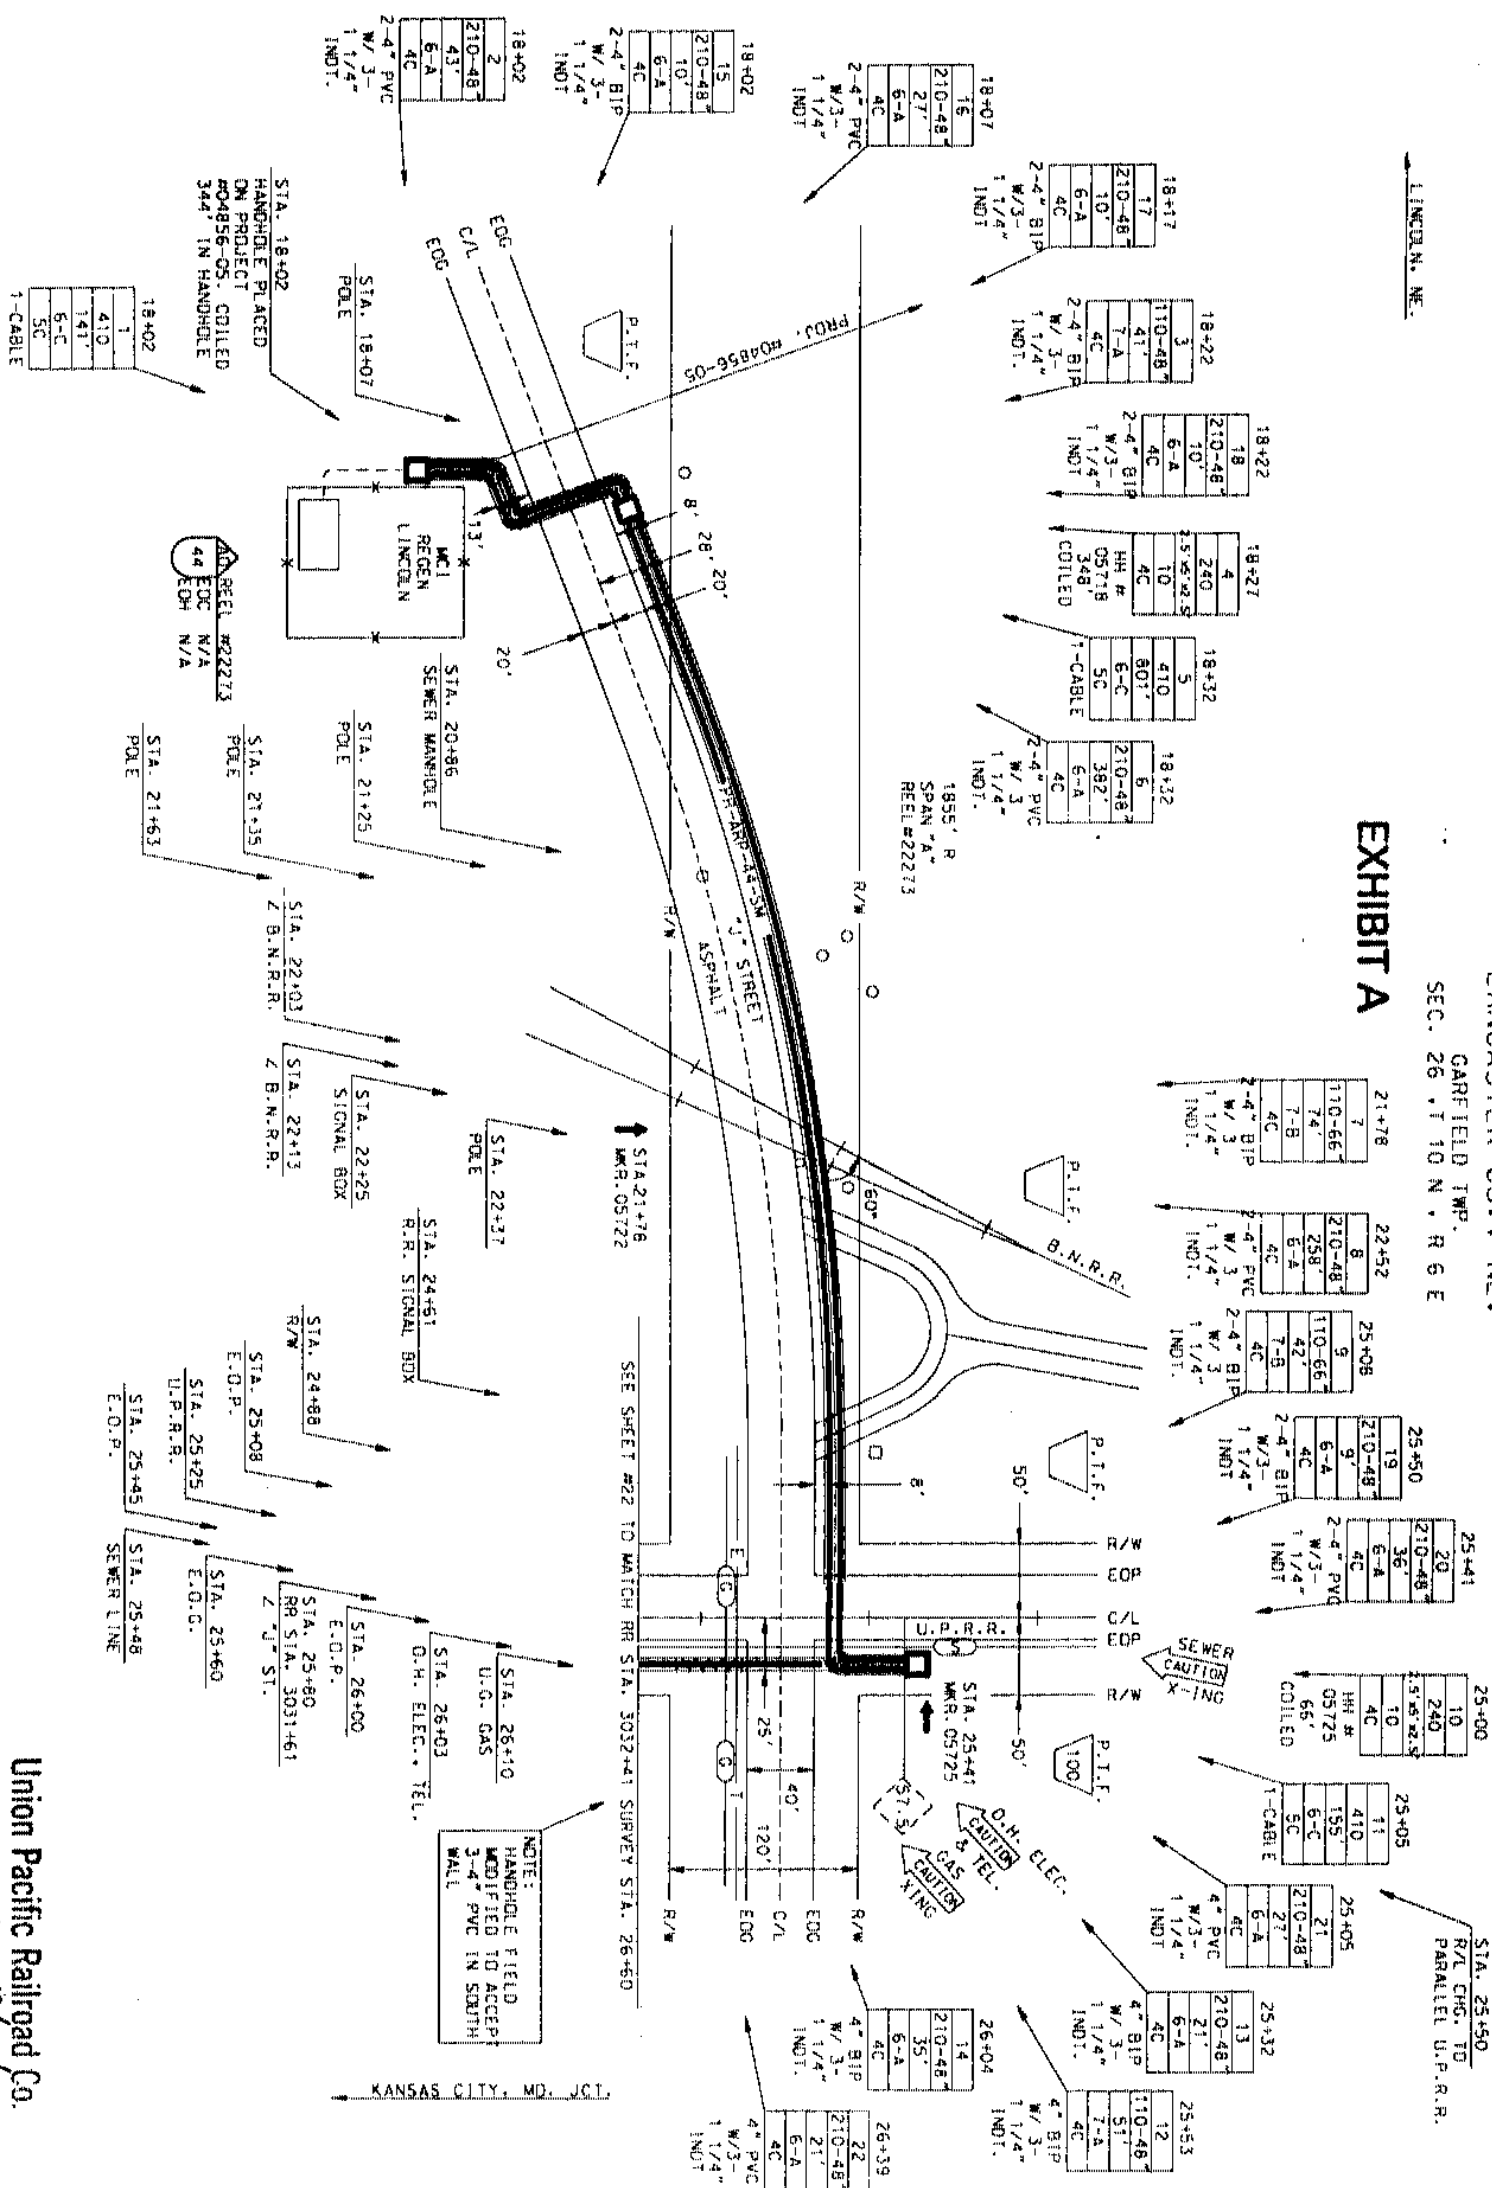

Union Pacific Railroad Co
APPROVED: Date 8/20/01

FOR VP ENGINEERING

PROJECT: #05660

SPAN: 2"

KANSAS CITY, MO, JCT. 10

LINCOLN, NE.



MAP FOOTAGE

SURVEY 853 LF

RAILROAD 853 LF

MATERIAL IS QUANTITY

CABLE	1855'
4" CIP	1540'
4" PVC	6117'
1/4" CORR. INDT	
4" SPLIT CIP	
4" SPLIT PVC	
HH 3' x 5' x 4'	
HH 4' x 4' x 4'	
BUR. C.A. WRS.	2
10M STRAND	
10S TELECASTING	
4" BIP	499'
2" H.D.P.E.	
HH 2.5' X5' X2.5'	2

MCI

TELECOMMUNICATIONS CORPORATION

TITLE: FIBEROPTIC CABLE ROUTE

KANSAS CITY, MO. JCT. LINCOLN, NE.

DATE

ENGINEER: COT

REVISIONS

DATE	DESCRIPTION	PAINTED
2-23-83	REVISION	COT
6-24-83	ISO UPDATE	END

SCALE: 1"=50'

VERTICAL: 1"=50'

HORIZONTAL: 1"=100'

MAP: 57 10MP 58

SHEET 21A OF 55F


END.

0566002T.A1A

LINCOLN, NE

LANCASTER CO., NE.
GARFIELD TWP.
SEC. 26, T. 10 N., R. 6 E

38+20	38+20	38+46	40+71	42+57
1	8	3	9	7
410	630-60'	210-48'	630-44'	210-48'
712'	28'	227'	187'	270'
6-C	6-F	6-A	6-A	6-A
5C	4C	4C	4C	4C
1-CABLE	4-BIP	4-PVC & 3-11/4" INDOT.	4-BIP	4-PVC & 3-11/4" INDOT.

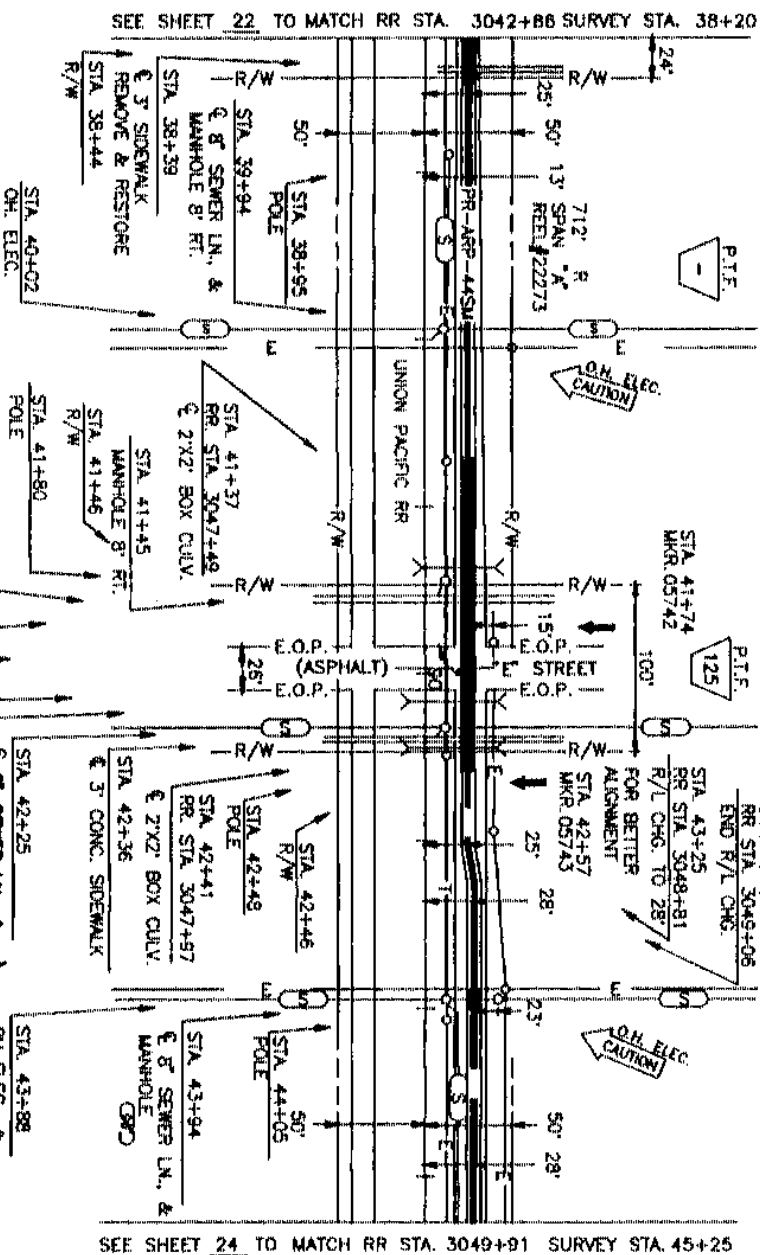

NOTE: STA 38+44 - STA 41+78
CUT & RESTORE GRAVEL -
334/668' SELECT BACKFILL

NOTE: STA 42+46 - STA 45+25
CUT & RESTORE GRAVEL
279/558' SELECT
BACKFILL

KANSAS CITY, MO. JCT.

PAS.

AUG 20 2007



PROJECT: # 05660

SPAN: -A-

KANSAS CITY, MO. JCT.
TO
LINCOLN, NE

MAP FOOTAGE

SURVEY 705 L

RAILROAD 705 L

MATERIAL LIST QUANTIT

CABLE 712'

4" GP 497'

4" PVC 497'

11/4" CORR. INDOT. 1491'

4" SPLIT GP 497'

4" SPLIT PVC 497'

100' STRAND 2

100' STEEL CASING 2

4" BIP 216'

Z HDPE 216'

MCI

TELECOMMUNICATIONS CORPORATION

TITLE: FIBER OPTIC CABLE ROUTE

KANSAS CITY, MO. JCT. TO LINCOLN, NE.

DATE

ENGINEER JEFFREY

REVISIONS

DATE DESCRIPTION

1-93 BY STA

1-94 AS-BUILT

1-94 AS-BUILT

SCALE

HORIZONTAL: 1" = 50'

VERTICAL: 1" = 50'


DEPT. ID. LOC. ID. 041

MP 52 TO MP 58

SHEET 23 OF 557

05660023.01A

LANCASTER CO., NE
GARFIELD TWP.
SEC. 26 , T 10 N , R 6 E

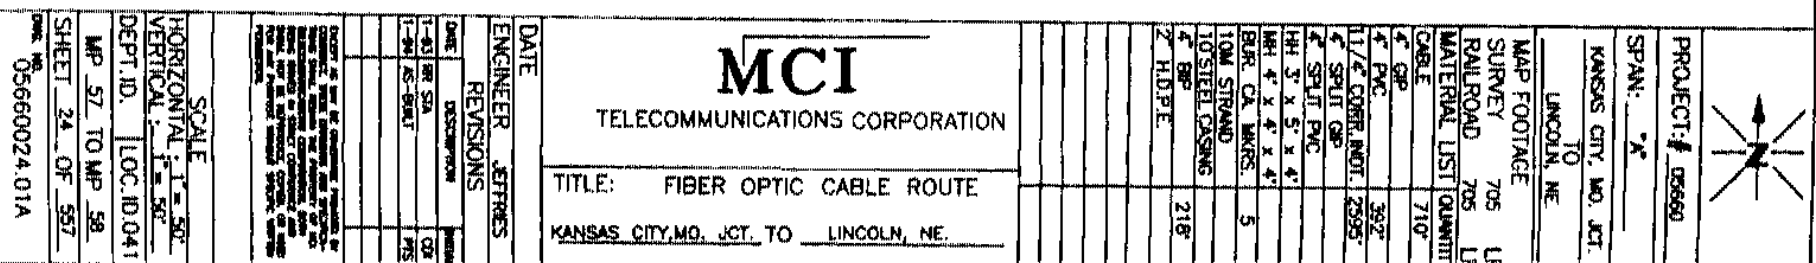

LANCASTER CO., NE.


CARFIELD TWP.

SEC. 26&35, T. 10 N - R. 6 E

LINCOLN, NE

NOTE: STA. 0+00-STA. 1+39
CUT & RESTORE GRAVEL
139/278' SELECT
BACKFILL

NOTE: STA. 1+39-STA. 5+41
CUT & RESTORE GRAVEL
402/804' SELECT
BACKFILL

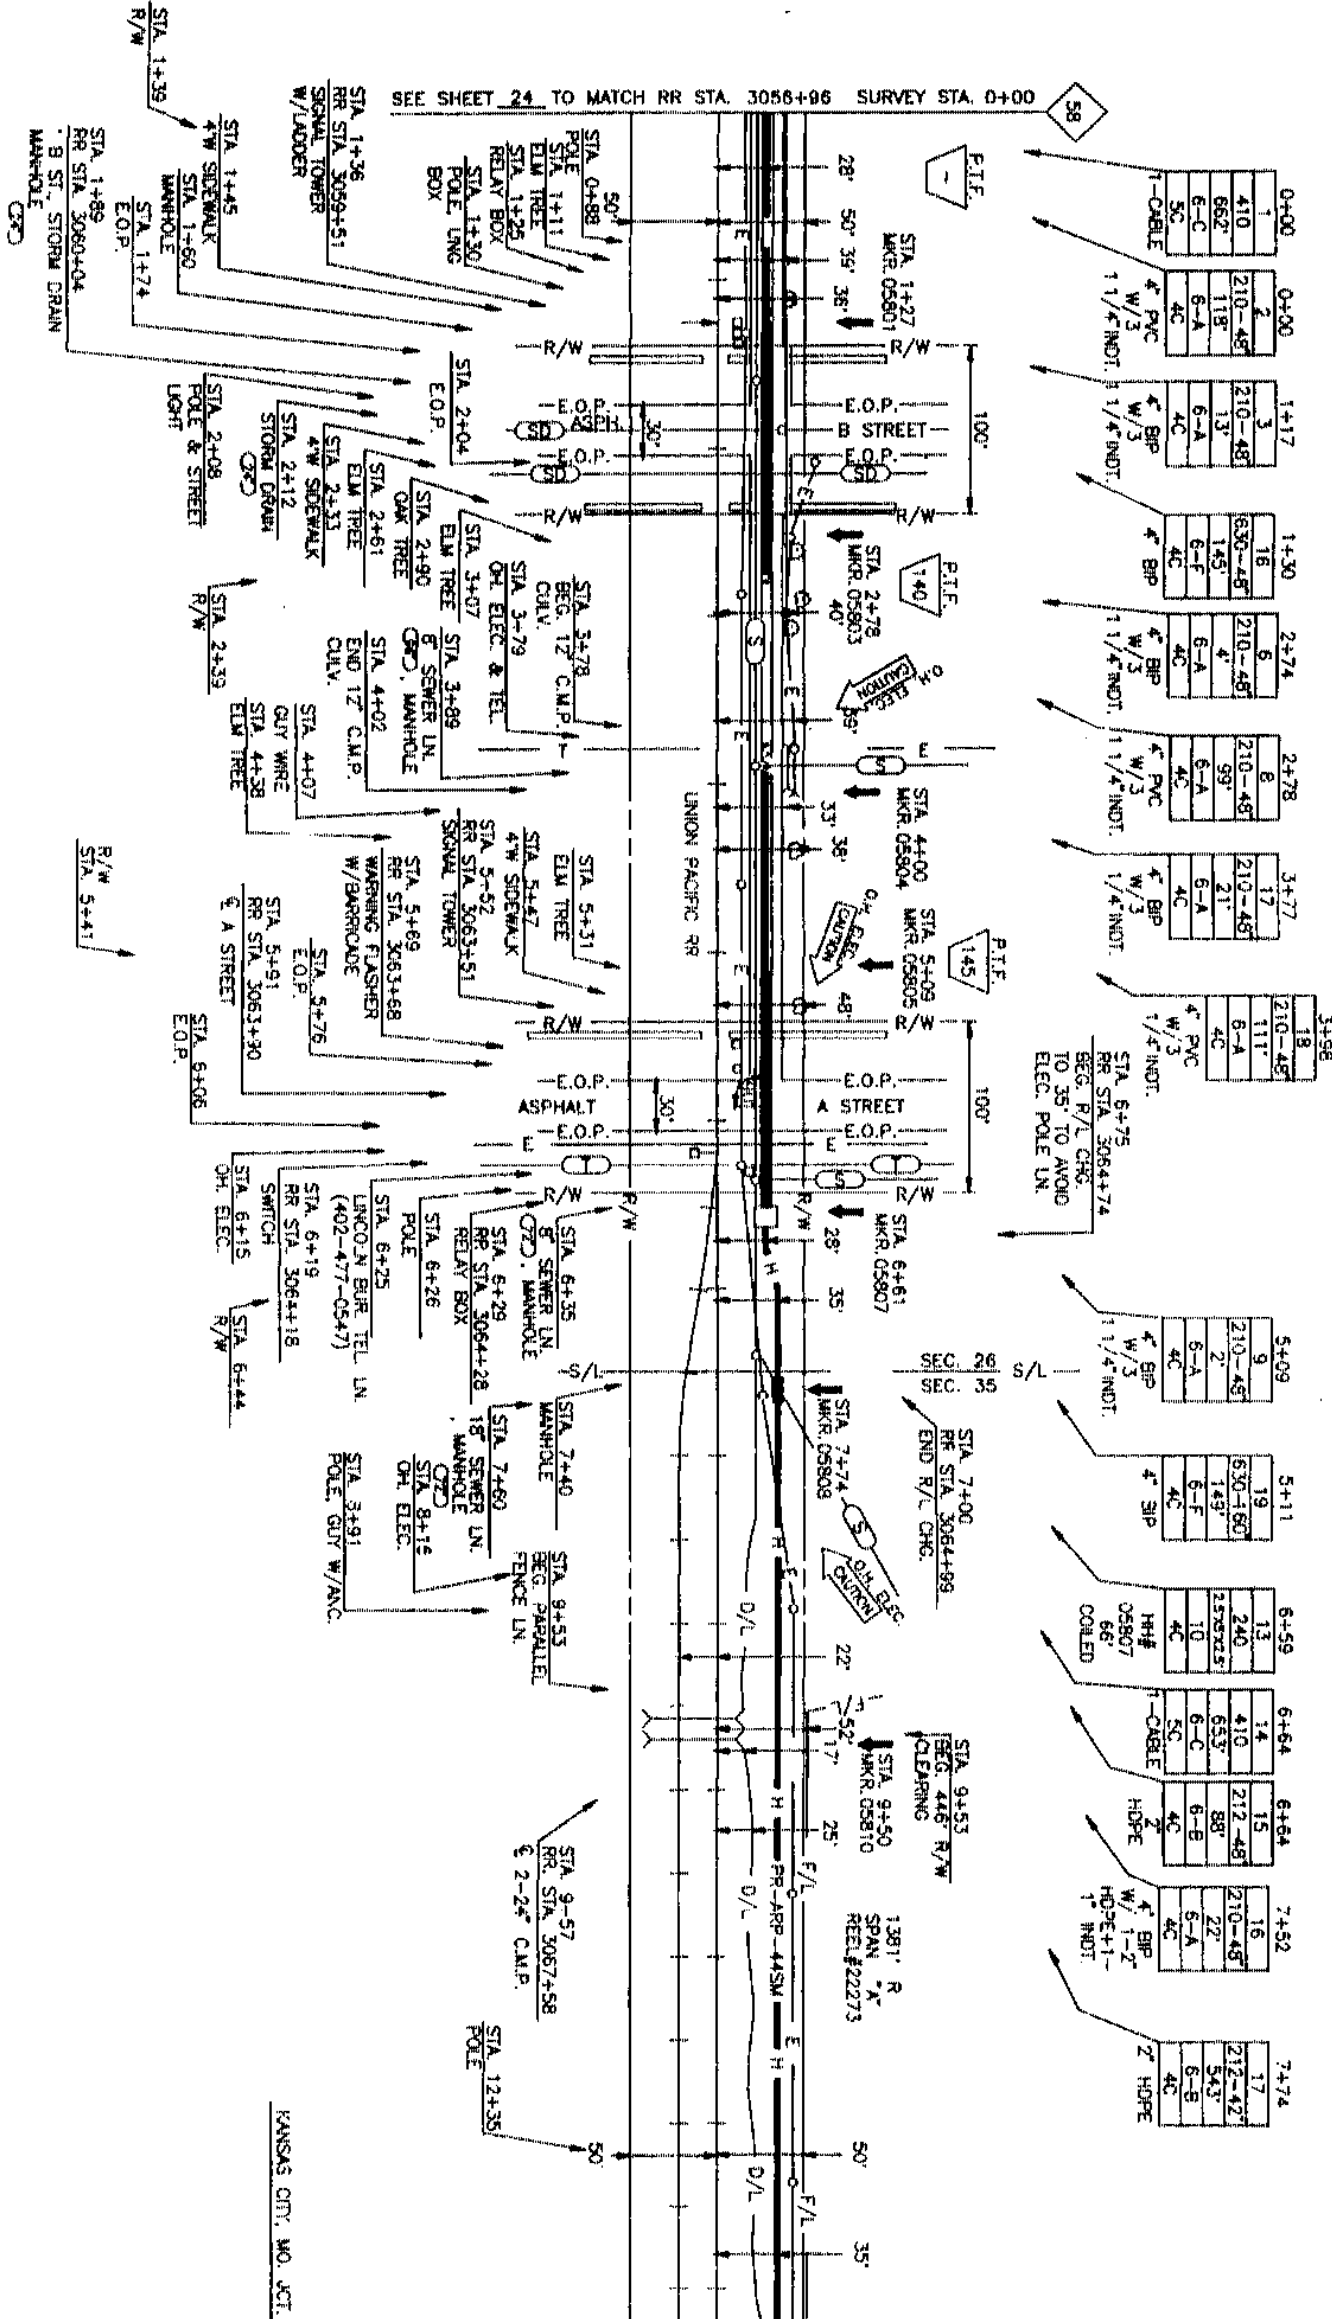

SEE SHEET 24 TO MATCH RR STA. 3056+96 SURVEY STA. 0+00

SEE SHEET 26 TO MATCH RR STA. 3070+16 SURVEY STA. 13+20

P.A.S.

AUG 20 2007



PROJECT: # 05660

SPAN: 1" A"

KANSAS CITY, MO. JCT.

TO
LINCOLN, NE.

MAP FOOTAGE

SURVEY 1320 L

RAILROAD 1320 L

MATERIAL LIST QUANTITY

CABLE 1381'

4" GP 325'

4" PVC 325'

11/2" CORR. INDT. 1104'

4" SPLIT GP

4" SPLIT PVC

10" STEEL CASKING

4" BRP 356'

2" HDPE 653'

H.H. 2.5X5X2.5' 1

RR ASPH. SOLFT. 22'

1" INDT 22'

MCI

TELECOMMUNICATIONS CORPORATION

TITLE: FIBER OPTIC CABLE ROUTE

KANSAS CITY, MO. JCT. TO LINCOLN, NE.

DATE

ENGINEER JEFFREY

REVISIONS

ONE

DESCRIPTION

1-431 RR STA

1-341 RR STA

SCALE

HORIZONTAL 1" = 50'

VERTICAL 1" = 50'

DEP. ID. LOC. ID. 041


MP 58 TO MP 59

SHEET 25 OF 557

05660025.01A

LANCASTER CO., NE.

LANCASTER CO., NE.
GARFIELD TWP.
SEC. 35, T 10 N-R 6 E

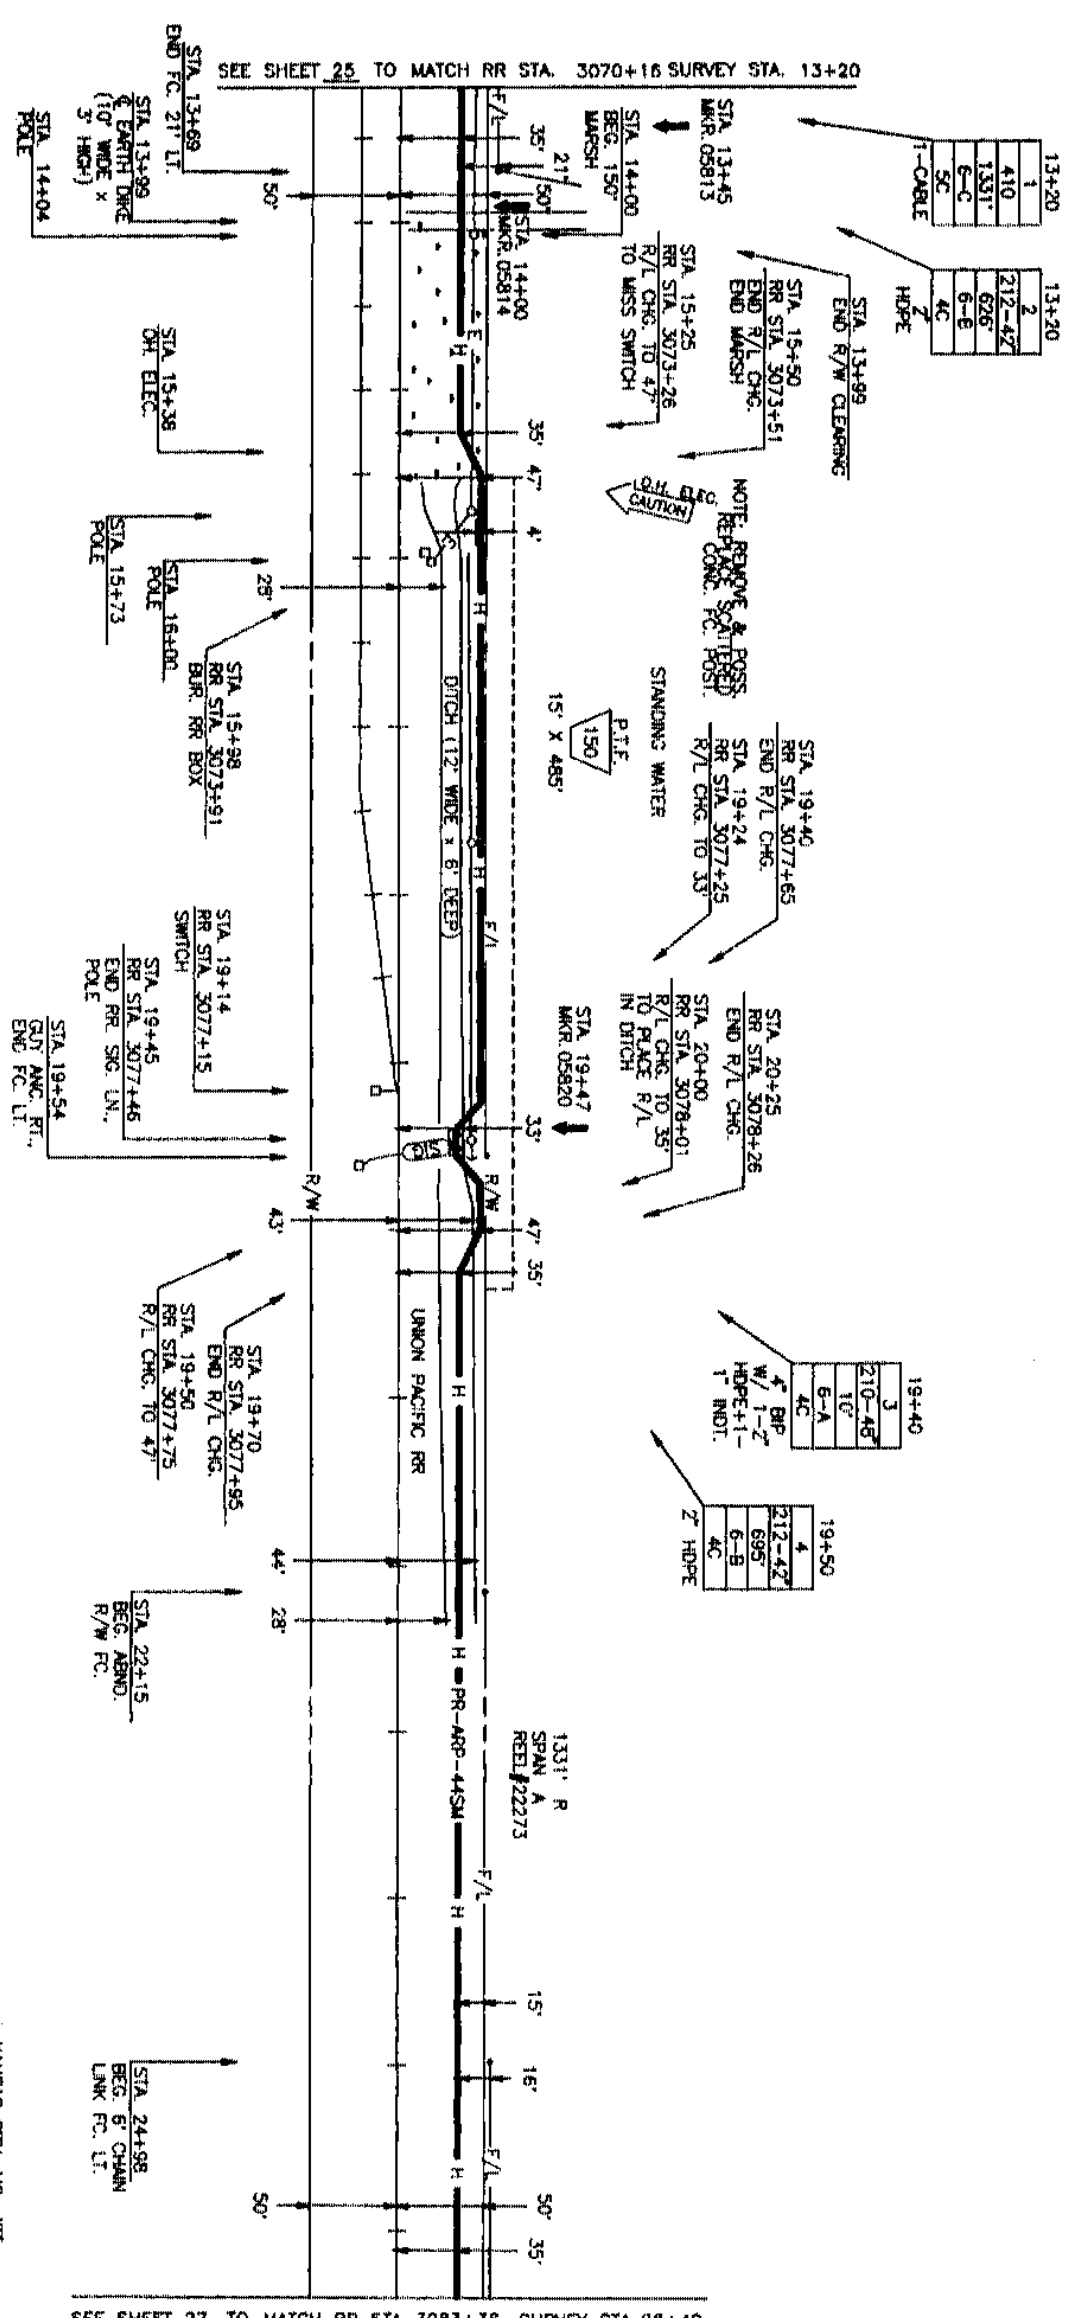

SEE SHEET 25 TO MATCH RR STA. 3070+16 SURVEY STA. 13+20

SEE SHEET 27 TO MATCH RR STA. 3083+36 SURVEY STA. 28+40

P.A.S.
AUG 20 2007



PROJECT: # 05660

SPAN: "A"

KANSAS CITY, MO. JCT. TO LINCOLN, NE.

MAP FOOTAGE

SURVEY 1320 L

RAILROAD 1320 L

MATERIAL LIST QUANTITY

CABLE 1331'

4" GIP 4'

4" PAC 4'

11/4 CORR. INDT. 4'

4" SPLIT GIP 4'

4" SPLIT PAC 4'

4" 3" x 5" x 4" 4'

4" 4" x 4" x 4" 4'

BUR. CA. MARKS 3

10M STRAND 10

10 STEEL CLOSING 10

4" BLP 10'

2" HOPE 10'

1" INDT 10'



TITLE: FIBER OPTIC CABLE ROUTE
KANSAS CITY, MO. JCT. TO LINCOLN, NE.

DATE

ENGINEER JEFFREY

REVISIONS

DATE DESCRIPTION

1-23-07 STA. CH

1-24-07 BUILT

1-24-07 BUILT


1-24-07 BUILT

1-24-07 BUILT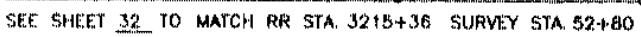

LANCASTER CO., NE.
YANKEE HILL TWP.
SEC. 11, T 9 N - R 6 E

26+40	2
1	212-42
410	1749
2647	6-B
6-C	4C
5C	
1-CABLE	HOPE

73-83
3
630-487
241*
6-F
4C
2
HOPE

40-23
4
212-42
657
6-5
4C
7 HOP




PROJECT # 05660	
SPAN: "A"	
KANSAS CITY, MO. JCT. TO LINCOLN, NE.	
MAP FOOTAGE SURVEY 2640 L RAILROAD 2640 L MATERIAL LIST QUANTITY	
CABLE	2647
4" GP	
4" PVC	
11/4" CORR INDT.	
4" SPLIT GP	
4" SPLIT PVC	
1/4" 3 x 5 x 4"	
1/4" 4 x 4 x 4"	
BUR. CA. MKRS.	3
10M STRAND	
10 STEEL CASING	
4" BIP	
2" H.D.P.E.	2647
1-1" INDT.	



TITLE: FIBER OPTIC CABLE ROUTE	
KANSAS CITY, MO. JCT. TO LINCOLN, NE.	

DATE	
ENGINEER JEFFREYS	
REVISIONS	
DATE	DESCRIPTION
1-43	BR. STA.
1-24	NO. BUILT

DESIGN BY: MCI TELECOMMUNICATIONS CORPORATION
 DRAWN BY: MCI TELECOMMUNICATIONS CORPORATION
 CHECKED BY: MCI TELECOMMUNICATIONS CORPORATION
 SCALE: HORIZONTAL: 1" = 50' VERTICAL: 1" = 50'
 DEPT. ID. LOC. ID. 041
 MP 60 TO MP 61
 SHEET 31 OF 557
 CIRCLE NO. 05660031.01A

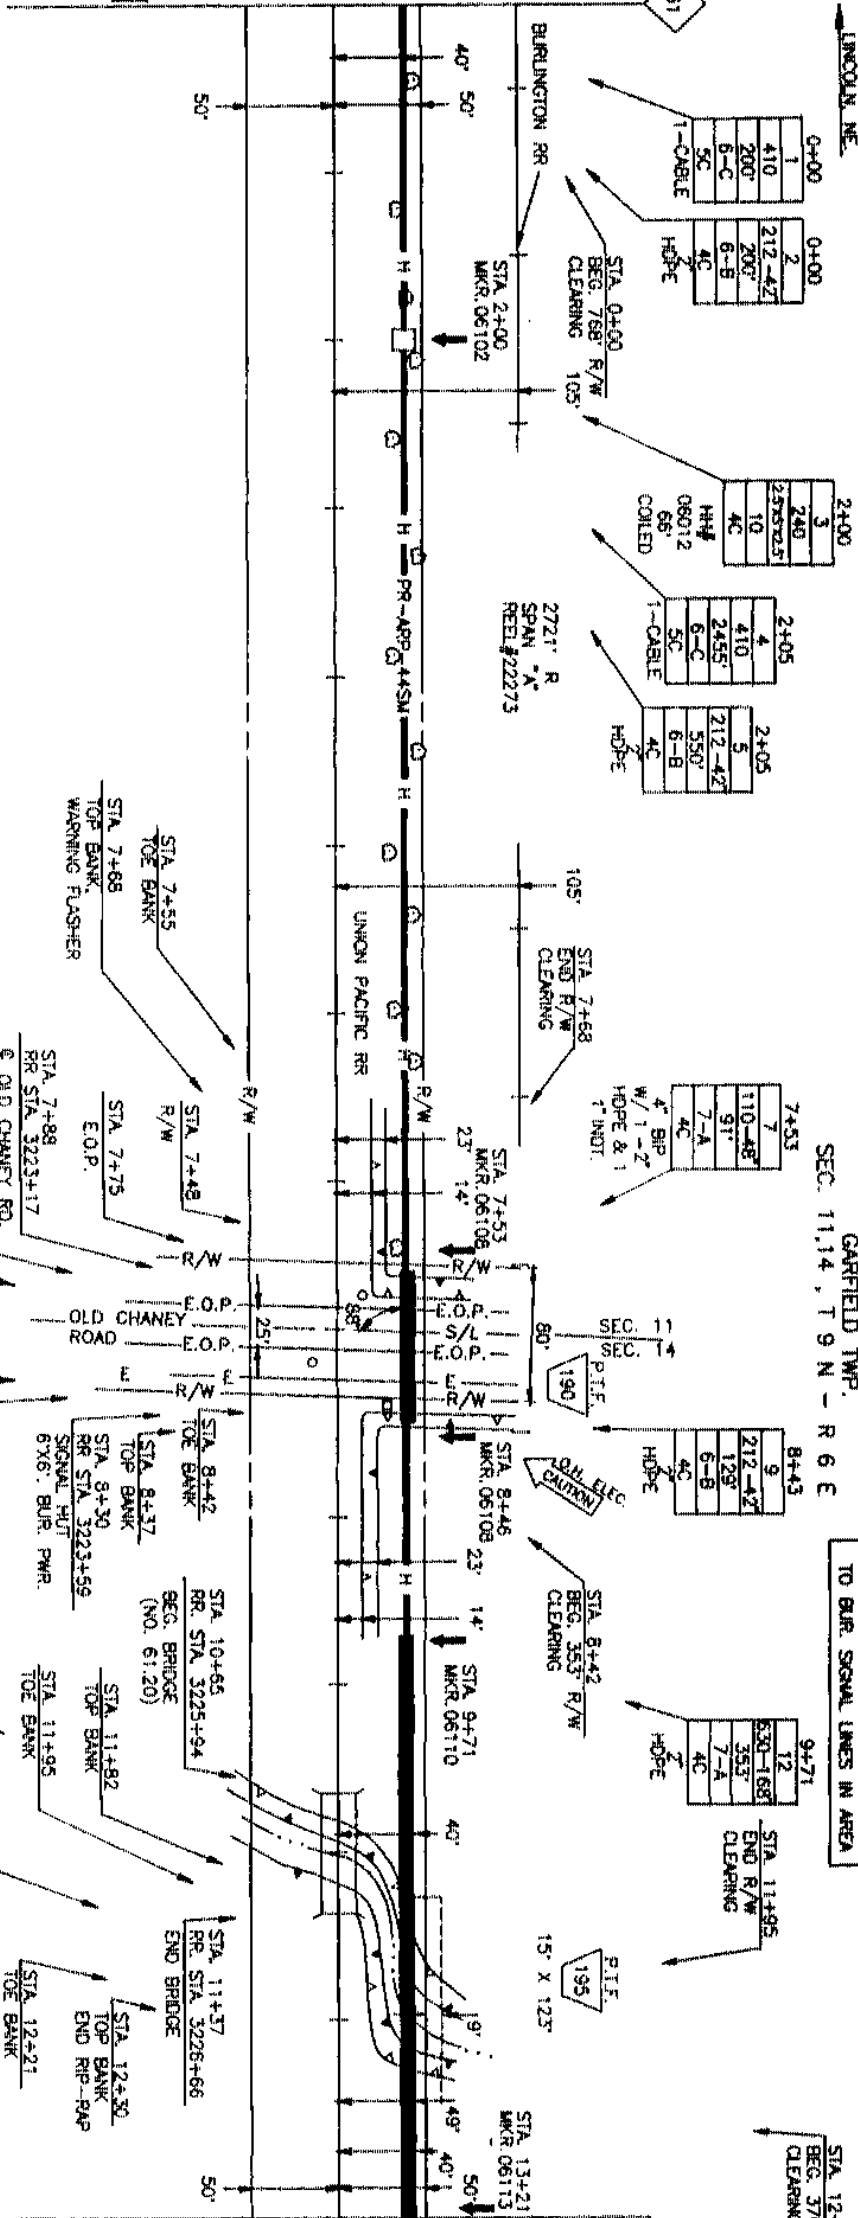

SEE THIS SHEET TO MATCH RR STA. 3228+56 SURVEY STA. 13+20

PROJECT: # 05660

SPAN: "A"

KANSAS CITY, MO. JCT. TO LINCOLN, NE.

MAP FOOTAGE	
SURVEY	2640 LF
RAILROAD	2640 LF
MATERIAL LIST QUANTITY	
CABLE	2727'
4" GIP	
4" PVC	
1 1/4" CORR. INDT.	
4" SPLIT GIP	
4" SPLIT PVC	
1H. 3" x 5" x 4"	
1H. 4" x 4" x 4"	
BUR. CA. LINKS	6
10" STEEL CASSING	
4" BIP	148'
2" H.D.P.E.	2652'
1" INDT.	148'
1H. 2.5"x5"x2.5"	1

TELECOMMUNICATIONS CORPORATION

TITLE: FIBER OPTIC CABLE ROUTE

KANSAS CITY, MO. JCT. TO LINCOLN, NE.

DATE

ENGINEER JEFFREYS

REVISIONS

DATE	DESCRIPTION	BY	CD	PTS
11-83	DR. STA.			
11-84	AS-BUILT			

CHECKED BY: J.E. JEFFREYS, PROJECT IN CHARGE

CONTRACT: THESE DRAWINGS AND SPECIFICATIONS ARE THE PROPERTY OF MCI TELECOMMUNICATIONS CORPORATION AND ARE NOT TO BE REPRODUCED OR TRANSMITTED IN ANY FORM OR BY ANY MEANS, ELECTRONIC OR MECHANICAL, INCLUDING PHOTOCOPYING, RECORDING, OR BY ANY INFORMATION STORAGE AND RETRIEVAL SYSTEM, WITHOUT PERMISSION IN WRITING FROM MCI TELECOMMUNICATIONS CORPORATION.

SCALE

HORIZONTAL: 1" = 50'

VERTICAL: 1" = 50'

DEPT. ID. LOC. ID. 0411

MP 61 TO MP 62

SHEET 32 OF 557

DWG. NO. 05660032.01A

SPAN: 2

LINCOLN, NE.

RAILROAD	2640
WATERWAY	11570

4. PVC	
--------	--

3' x 5' x 4'	
--------------	--

10" STEEL CASTING

1°	1407	17
HD	2.5 X 5 X 2.5	2

ATI
JTE®

CONFIDENTIAL

ATIC

THE MML BEST ECONOMY IN THE WORLD BER

TELE

DATE _____

DATE	DESCRIPTION
------	-------------

[illegible]

THE NEW YORK PUBLIC LIBRARY

SCALE

DERID. 130.0

05560033.01A

05560033.01A

TELECOMMUNICATIONS CORPORATION

TITLE: FIBER OPTIC CABLE ROUTE

KANSAS CITY, MO. JCT TO LINCOLN, NE.

FORM

海

Copyright Clearance Center

1251

THE

At 1

330

1

50

51

1

11

57

1

100

1

1



2
3
4

1



LAKE HILL, PA.
SEC. 14, 23, T 9 N - R 6 E

STIA 10+37
BEG. 2627 R/W
CLEARING

50.

22

SEE SHEET 3.3 TO MATCH RR STA. 3268+16 SURVEY STA. 0+00

SEE THIS SHEET TO MATCH RR STA. 3281+36 SURVEY STA. 13+20

PAS.
AUG 20 2001

2.5'x5'x2.5'	HH
--------------	----

TITLE: FIBER OPTIC CABLE ROUTE
KANSAS CITY, MO. JCT. TO LINCOLN, NE.

REPRODUCTION OF THIS INFORMATION FOR
PERSONAL OR INTERNAL USE OF SPECIFIC CLIENTS
OR FOR THE INTERNAL OR EXTERNAL USE OF
ANY INDIVIDUAL OR ENTITY IS PROHIBITED.

KNOWS AS FAR AS CURRENT PROBLEMS & CONCERNS WITH TARRANT AND SPECIAL AGENT, REGARDING THE PROPERTY OF HIS INTERESTS, AND THE COMPANY, BEING OWNED BY THE COMPANY, AND THAT THE COMPANY IS CURRENTLY COVERED BY THE COMPANY, AND THAT THE COMPANY IS CURRENTLY COVERED BY THE COMPANY.

05560034.01A



PROJECT # 05660

SPAN: "A"

KANSAS CITY, MO. JCT.

TO

LINCOLN, NE.

MAP FOOTAGE

SURVEY 2676

RAILROAD 2676

MATERIAL LIST QUANTITY

CABLE 2698'

4" PVC

31/2" CORR. INUT.

4" SPLIT PVC

1 1/4" x 5' x 4'

1 1/4" x 4' x 4'

BLK. CA. MKRS. 2

10" STEEL CASING

4" BIP

2" H.O.P.E. 2698'

1" INUT.

MCI

TELECOMMUNICATIONS CORPORATION

TITLE: FIBER OPTIC CABLE ROUTE
KANSAS CITY, MO. JCT. TO LINCOLN, NE.

DATE

ENGINEER JEFFREY

REVISIONS

DATE DESCRIPTION

1-93 BY STA

1-94 BY STA

1-94 BY STA

SCALE

HORIZONTAL: 1" = 50'

VERTICAL: 1" = 50'

DEPT. ID. LOC. ID. 041

MP 52.70 MP 53

SHEET 35 OF 557

DWG. NO. 05660035.01A

LANCASTER CO., NE.

SEC. 23, T 9 N - R 6 E

STA. 26+40
CONTINUE R/W
CLEARING

STA. 36+64
END R/W
CLEARING

STA. 36+84
BEG. 1632' R/W
CLEARING

HEAVY CLEARING

2698' R
SPAN "A"
REEL #22273

STA. 34+00
MKR. 06234

ABAND. RD.

SEE SHEET 34 TO MATCH RR STA. 3294+56 SURVEY STA. 26+40

SEE THIS SHEET TO MATCH RR STA. 3307+76 SURVEY STA. 39+60

KANSAS CITY, MO. JCT.

STA. 44+00
MKR. 06244

P.T.F.
215'

47+70	48+36
3	4
212-47	212-47
67	487
6-B	6-B
4C	4C
H.O.P.E.	H.O.P.E.

STA. 48+16
BEG. STA. 3315+50
48' C.M.P. CULV.

STA. 47+90
BEG. STA. 3316+03
48' C.M.P. CULV.

STA. 48+03
BEG. STA. 3316+17
48' C.M.P. CULV.

SEE THIS SHEET TO MATCH RR STA. 3307+76 SURVEY STA. 39+60

SEE SHEET 36 TO MATCH RR STA. 3320+86 SURVEY STA. 53+16

P.A.S.
AUG 20 2001

SPAN: "A"

LINCOLN, NE

RAILROAD	2620	1
----------	------	---

4	5
PVC	

4	301.76
5	3' x 5' x 4'

10M STRAND	
10 STEEL CASING	

25x5x2.5'

--	--

ATION
UTE
E.

CON
LE
HCO

C ATION TIC O

1
IMU
BER
MO.

FILE

DATE _____

ACTIVITIES		DATE	DESCRIPTION	BY
------------	--	------	-------------	----

1000

[illegible]

SCALE

DEPT. OF COMMERCE

056603601A

05550038.01A

TELECOMMUNICATIONS CORPORATION

TITLE: FIBER OPTIC CABLE ROUTE

KANSAS CITY, MO. JCT TO LINCOLN, NE.

CANCER CENTRES

93	DIRECTIONAL DREF	CD
----	------------------	----

[illegible]

其後，三國志、晉書、宋書、南齊書、梁書、陳書、魏書、北齊書、周書、隋書、南史、北史、舊唐書、新唐書、宋史、明史、清史稿等史書，均採用此種編年體例。

VERTICAL: $\frac{1}{2} = 50'$

MP 63 TO MP 64

0566036.01A

LANCOLN, NE.

LANCASTER CO., NE.
YANKEE HILL TWP.
SEC. 36, T 9 N - R 6 E

26+70	26+70
1	2
410	212-42
1717	1717
6-C	6-B
5C	4C

STA. 26+70
CONTINUE R/W
CLEARING

2718' R
SPAN "A"
REF. #22103

STA. 36+26
RR STA. 3411+15
E 24' C.M.P. CULV.


SEE SHEET 38 TO MATCH RR STA. 3400+46 SURVEY STA. 26+70

SEE THIS SHEET TO MATCH RR STA. 3413+66 SURVEY STA. 39+90

KANSAS CITY, MO. JCT.

SEE THIS SHEET TO MATCH RR STA. 3413+66 SURVEY STA. 39+90

SEE SHEET 40 TO MATCH RR STA. 3426+56 SURVEY STA. 53+35

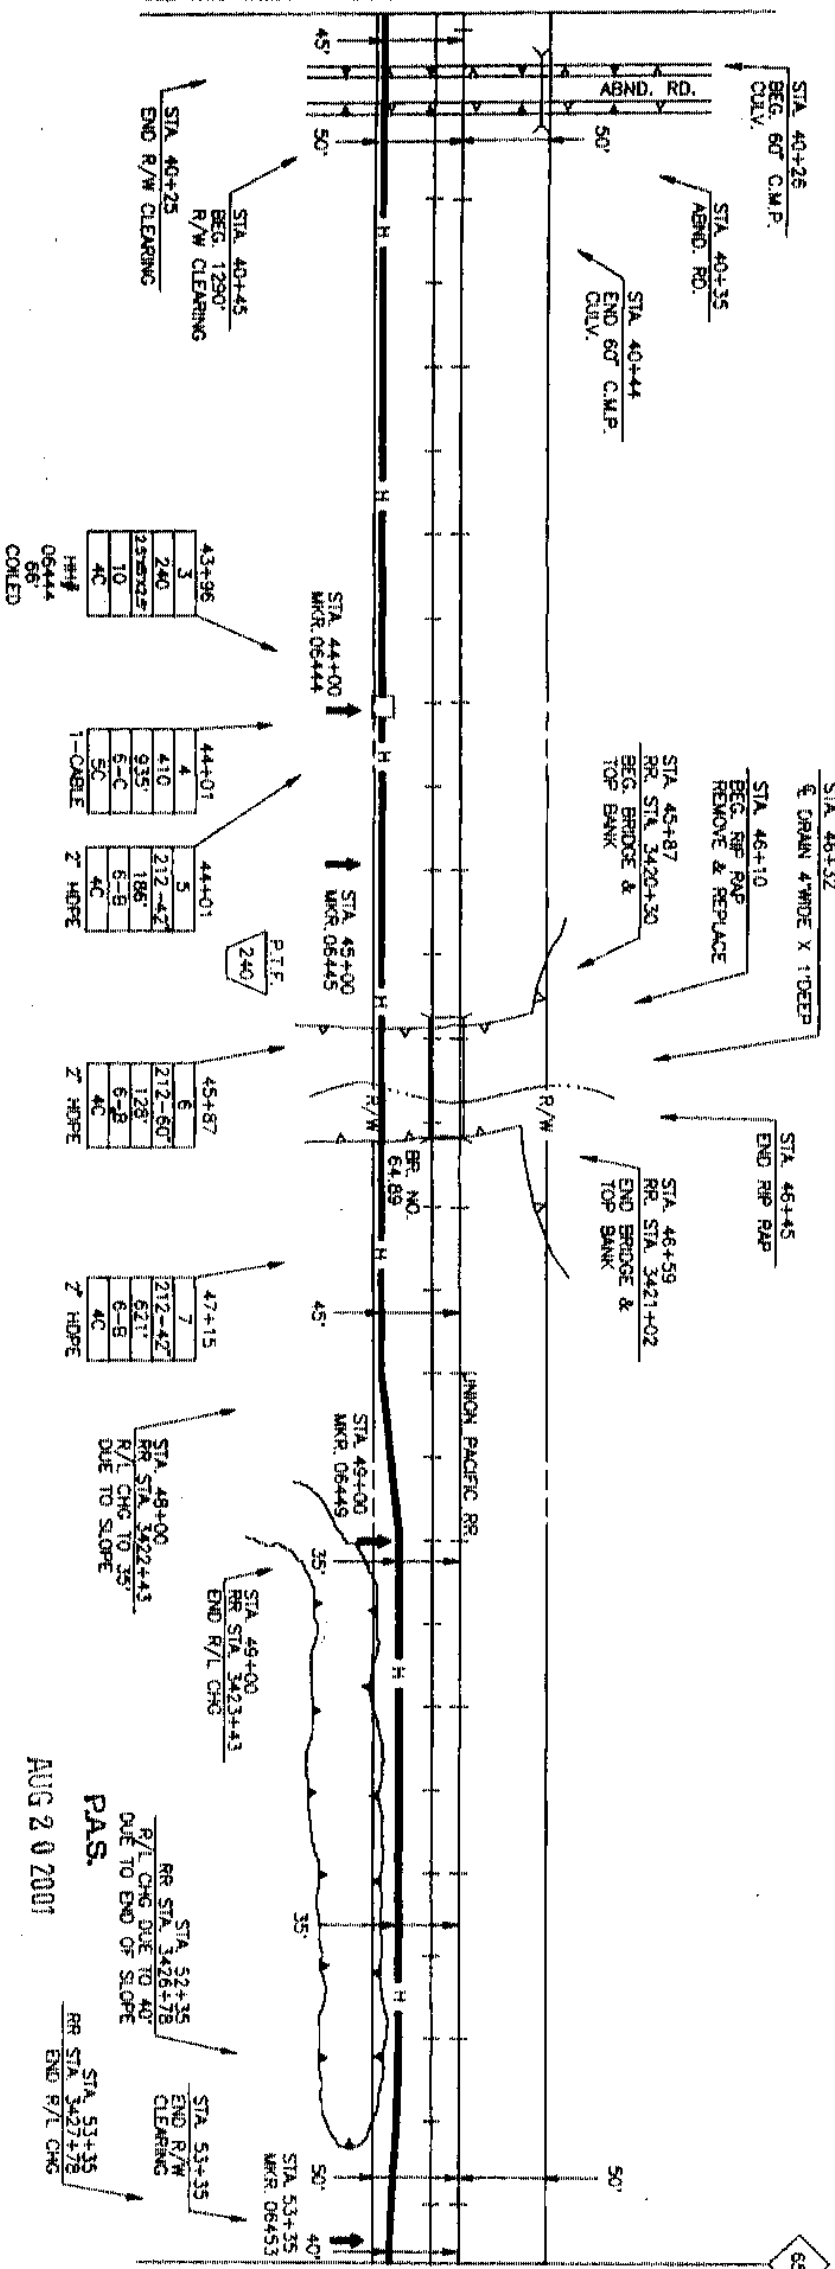

43+96
3
240
257222
10
4C
1111
06444
66
COILED

44+01	4
410	212-42
935	186
6-C	6-B
5C	4C

45+87	5
212-42	128
6-B	4C

47+15	7
212-42	621
6-B	4C

STA. 48+00
RR STA. 3422+43
R/L CHG DUE TO 35'
DUE TO SLOPE

STA. 52+35
RR STA. 3426+78
R/L CHG DUE TO 40'
DUE TO END OF SLOPE

STA. 53+35
END R/W
CLEARING

STA. 53+78
RR STA. 3427+78
END R/W CHG

AUG 20 2001

P.A.S.



PROJECT: # 05660
KANSAS CITY, MO. JCT.
TO
LINCOLN, NE.

SPAN: "A"

MAP FOOTAGE
SURVEY 2665
RAILROAD 2665
MATERIAL LIST QUANTITY
CABLE 2718'

4" GP
4" GP
11/4" CORR. NOT.
4" SPLIT GP
4" SPLIT PAC
11H 3' x 5' x 4'
11H 4' x 4' x 4'
BLR. CA. W/RS. 5
104 STRAND
10 STEEL CASING
4" BIP
2" H.D.P.E. 2652'
11H 2.5'x5'x2.5' 1
1" INDIT.

DATE
ENGINEER JEFFREY
REVISIONS
DATE DESCRIPTION
1-31 REVISION
1-31 REVISION
1-31 REVISION

SCALE
HORIZONTAL: 1" = 50'
VERTICAL: 1" = 50'
DEPT. ID. LOC. ID. 0.41
MP 64 TO MP 65
SHEET 39 OF 557
05660039.01A




TELECOMMUNICATIONS CORPORATION

TITLE: FIBER OPTIC CABLE ROUTE
KANSAS CITY, MO. JCT. TO LINCOLN, NE.

LANCASTER CO., NE.
YANKEE HILL & CENTERVILLE TWP.
SEC. 36, 1. T9N - R6E, T8N - R6E

STA. 8+43
WILLIAMS PIPELINE
(918-588-3200)

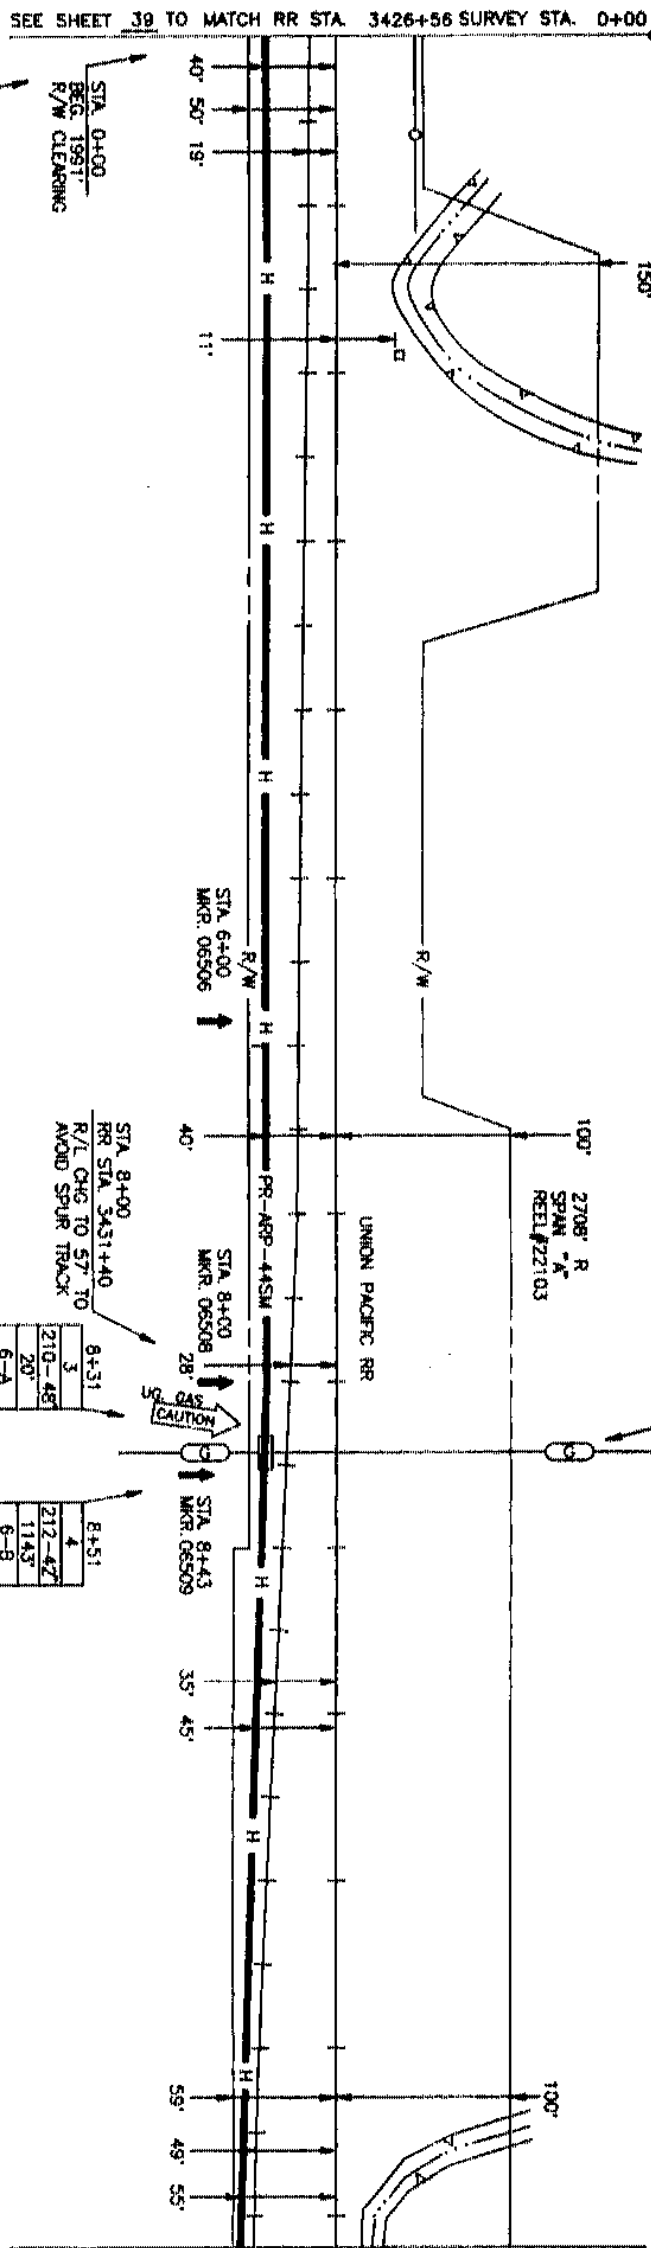

0+00	2
1	212-47
410	830'
1996'	6-C
6-C	6-B
SC	4C
1-CABLE	HOPE


8+31	3
210-48	20'
6-A	4C
6-B	4C
6-C	4C
1-CABLE	HOPE

8+51	4
212-47	1143'
6-B	4C
6-C	4C
1-CABLE	HOPE

STA 18+25
RR STA 3441+65
SWITCH

STA 20+38
RR STA 3444+07
& SALTILLO RD.
STA 20+35
TELE BOX 1071
STA 20+24
E.O.P.
STA 20+21
TOP SLOPE
STA 20+14
TOE SLOPE
STA 20+00
R/W

STA 20+51
E.O.P.
STA 20+54
TOP BANK
STA 20+52
TOE SLOPE
STA 20+85
OH ELEC.
STA 20+86
R/W
STA 20+98
PWR. POLE W/ DROOP
& METER
STA 21+10
CONC. POST

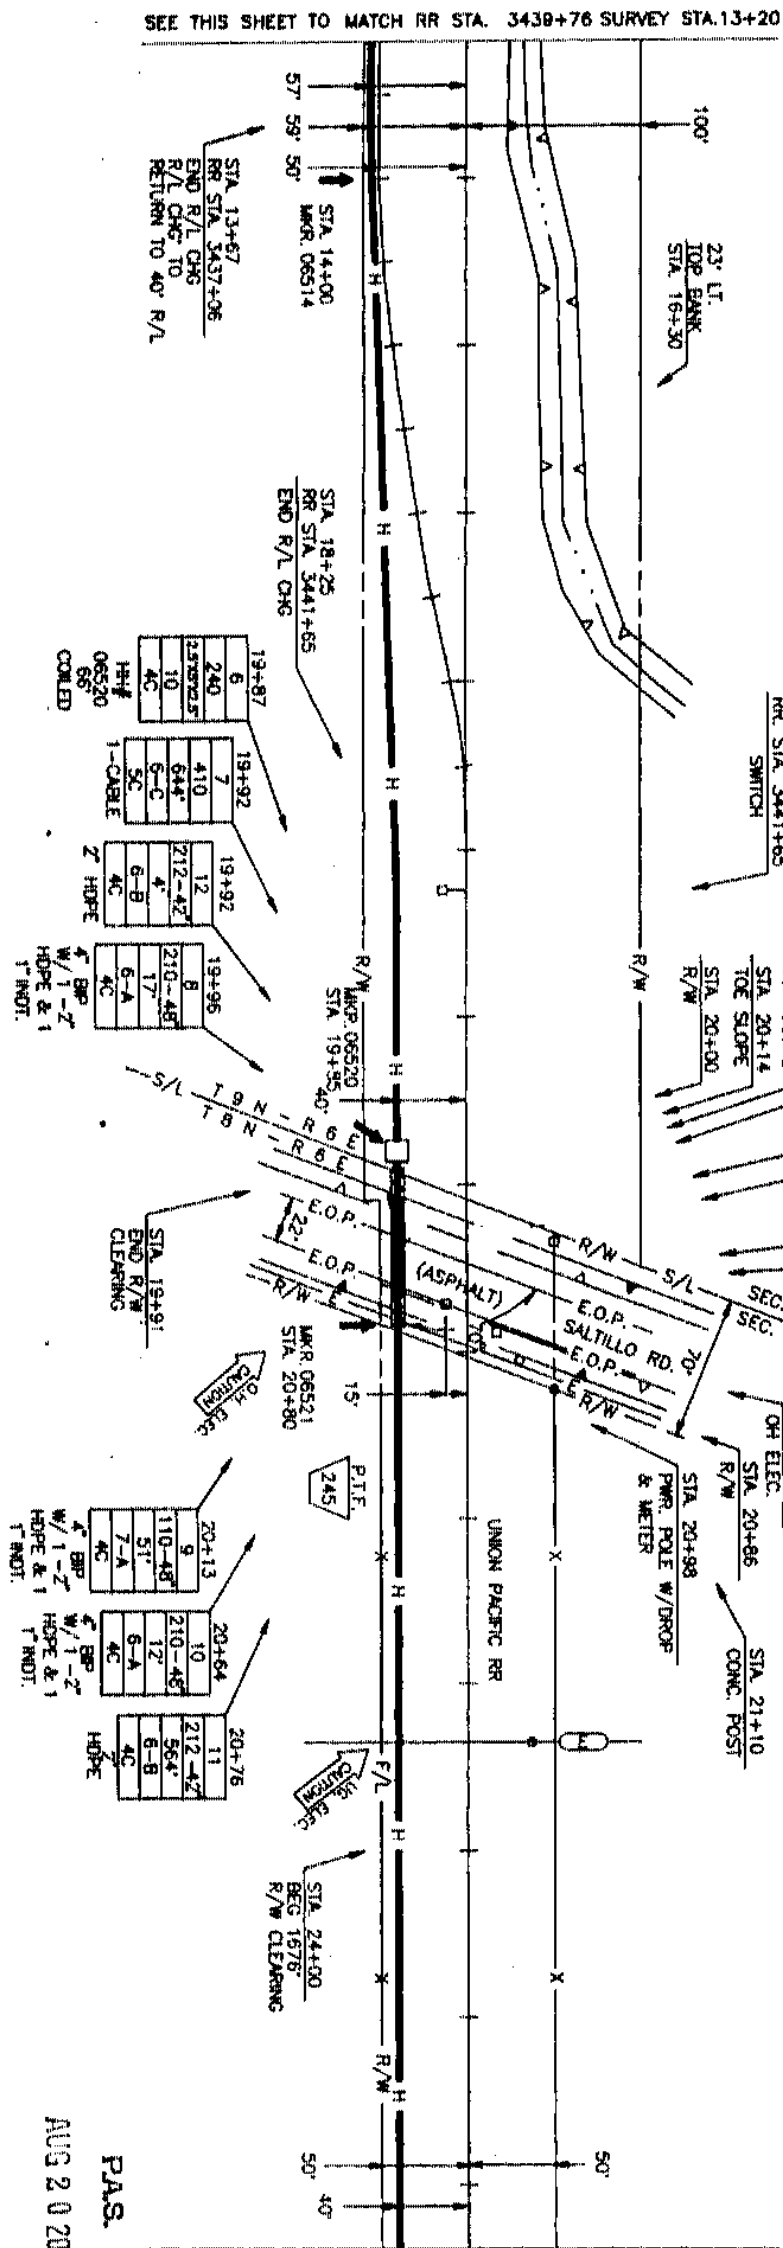

19+87	6
240	410
228725	644'
10	6-C
4C	6-B
SC	4C
1-CABLE	HOPE
06520	6-A
68	4C
CONC'D	4C
1-CABLE	HOPE
1 INOT.	HOPE & 1

20+13	9
210-48	12
57	7-A
4C	6-A
4C	4C
1-CABLE	HOPE
4 BP	W/1-2
W/1-2	HOPE & 1
1 INOT.	HOPE & 1

P.A.S.
AUG 20 2007



PROJECT: 05660

SPAN: 2640

KANSAS CITY, MO. JCT.

TO

LINCOLN, NE.

MAP FOOTAGE

SURVEY 2640

RAILROAD 2640

LF

MATERIAL LIST QUANTITY

CABLE

2708'

4 GP

4 PVC

11/4" CORR. INOT.

4 SPLIT GP

4 SPLIT PVC

1 1/4" x 5' x 4'

1 1/4" x 5' x 4'

MCI
TELECOMMUNICATIONS CORPORATION

TITLE: FIBER OPTIC CABLE ROUTE
KANSAS CITY, MO. JCT. TO LINCOLN, NE.

DATE	ENGINEER	JEFFRIES
REVISIONS	DESCRIPTION	DATE
1-03	MODIFIED	03
1-04	AS-BUILT	03

SCALE
HORIZONTAL: 1" = 50'
VERTICAL: 1" = 50'
DEPT. ID. LOC. ID. 041
SHEET 40 OF 557
MP 55 TO MP 65
SHEET 40 OF 557
05660040.01A



PROJECT: 05660

SPAN: 1

KANSAS CITY, MO. JCT. TO LINCOLN, NE

MAP FOOTAGE

SURVEY 2564 U

RAILROAD 2564 U

MATERIAL UST QUANT

CABLE 2704'

4" GP

4" PVC

11/4" CORR. MNT.

4" SPLIT GP

4" SPLIT GP

MCI

TELECOMMUNICATIONS CORPORATION

TITLE: FIBER OPTIC CABLE ROUTE

KANSAS CITY, MO. JCT. TO LINCOLN, NE

DATE

ENGINEER

REVISIONS

DATE

DESCRIPTION

DATE

DESCRIPTION

SCALE

HORIZONTAL: 1" = 50'

VERTICAL: 1" = 50'

DEPT. ID. LOC. ID. 04

MP 55 TO MP 56

SHEET 41 OF 557

NO. 05660041.01A

LANCASTER CO., NE.


CENTERVILLE & SALTILLO TWP.

SEC. 6 & 1, T 8 N - R 6 E, T 8 N - R 7 E

2704' R
SPAN "A"
REEL #22103


UNION PACIFIC RR

SEE SHEET 40 TO MATCH RR STA. 3452+96 SURVEY STA. 26+40

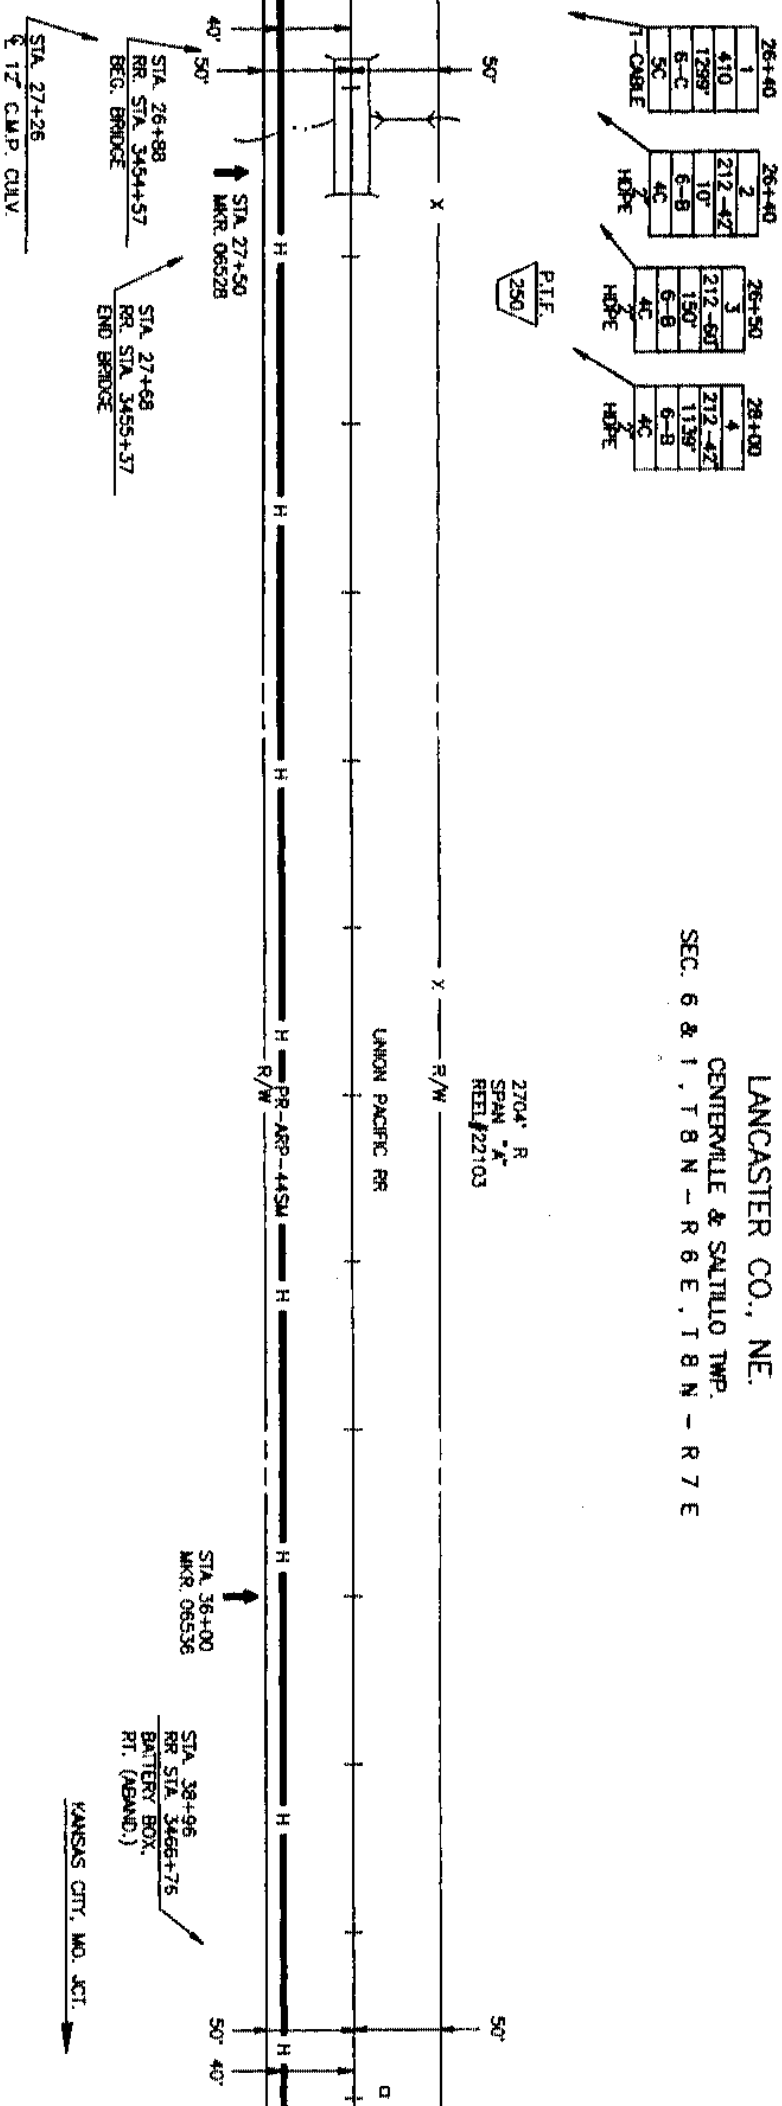

SEE THIS SHEET TO MATCH RR STA. 3463+66 SURVEY STA. 39+10

SEE THIS SHEET TO MATCH RR STA. 3463+66 SURVEY STA. 39+10

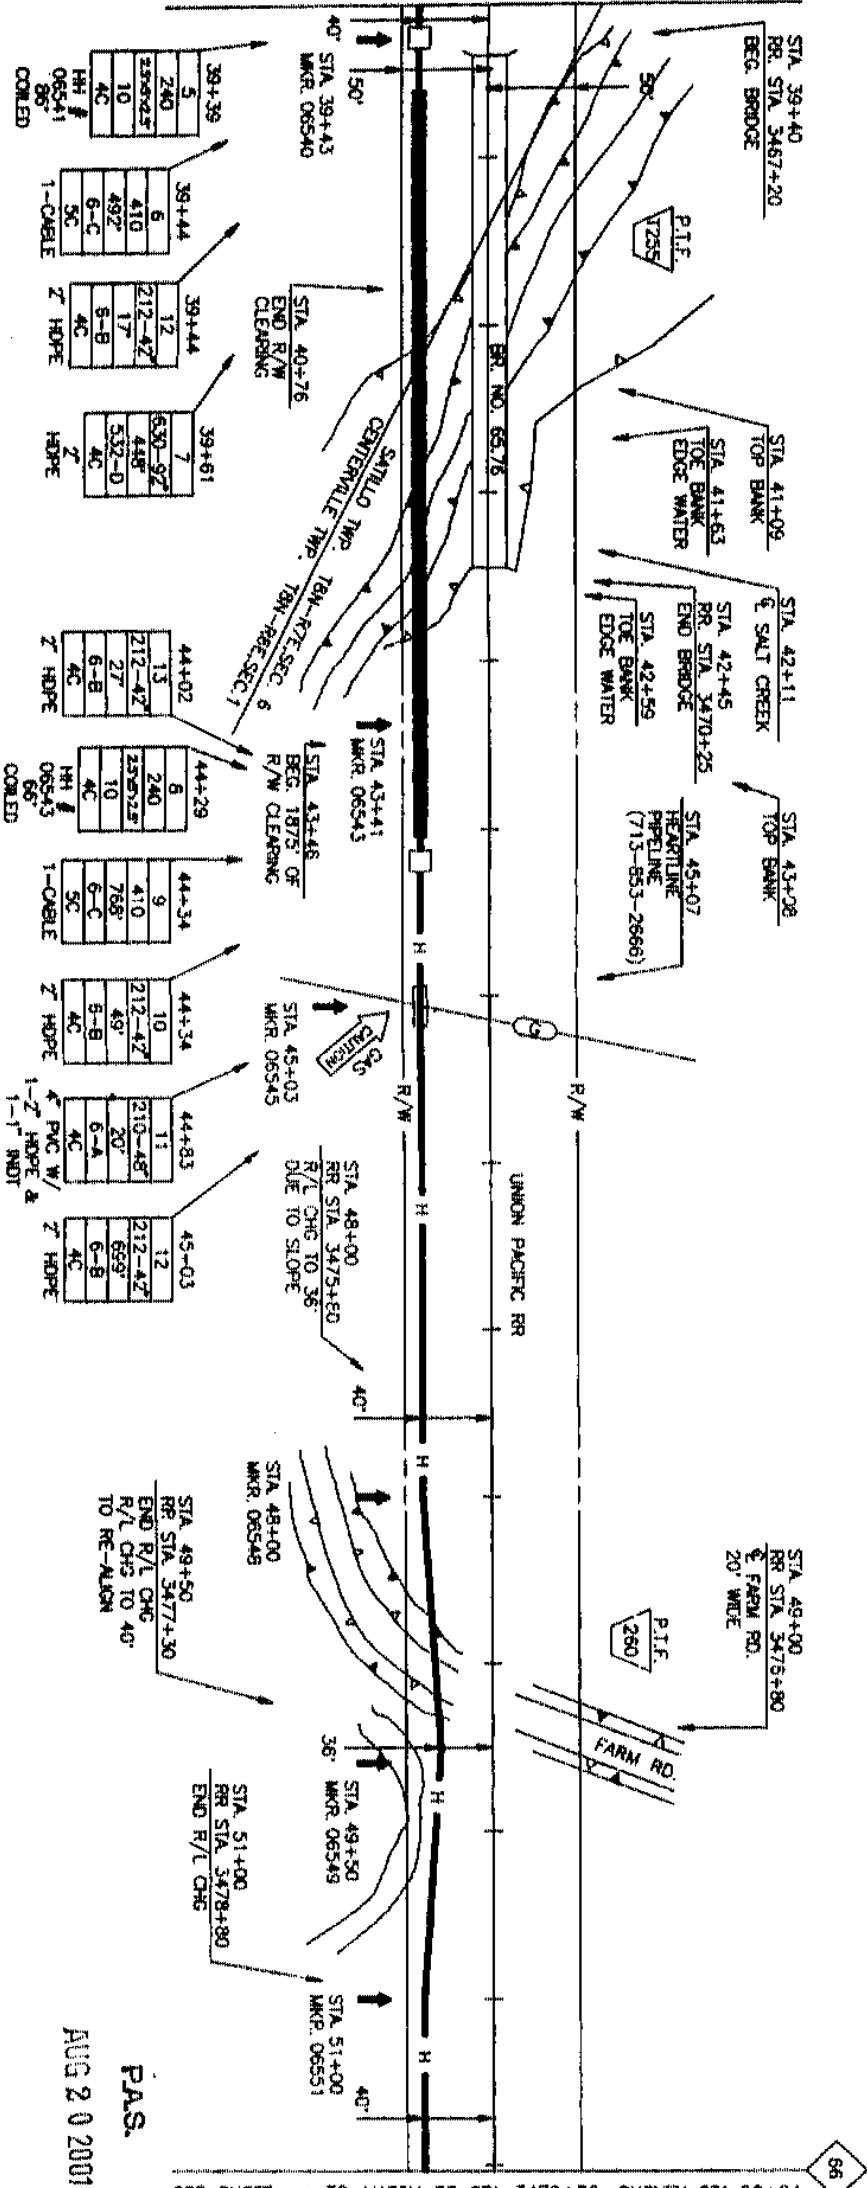

SEE SHEET 42 TO MATCH RR STA. 3479+36 SURVEY STA. 52+04

PAS.
AUG 20 2001



PROJECT: # 05660

SPAN: - "X"

KANSAS CITY, MO. JCT.

TO LINCOLN, NE.

MAP FOOTAGE SURVEY 2642 U

RAILROAD 2642 U

MATERIAL LIST QUANTITY

CABLE 2701'

4" GP 2701'

11/2" CORR. MDI.

4" SPLIT PVC

HH 3" x 5' x 4'

HH 4" x 4' x 4'

BUR. CA. W/RS. 3

10' STRAND

10' STEEL CASING

4" BPP 60'

2" HDPE 2635'

1" MDI. 60'

HH 2.5x2.5x2.5' 1

MCI

TELECOMMUNICATIONS CORPORATION

TITLE: FIBER OPTIC CABLE ROUTE

KANSAS CITY, MO. JCT. TO LINCOLN, NE.

DATE

ENGINEER JEFFRIES

REVISIONS

DATE DESCRIPTION

1-23 REVISION

7-24 AS-BUILT

DATE DESCRIPTION

SCALE

HORIZONTAL: 1" = 50'

VERTICAL: 1" = 50'

DEPT. ID. LOC. ID. 041

MP 55 TO MAP 57

SHEET 43 OF 557

Drawn by 05660043.01A

LANCASTER CO., NE.

SATILLO TWP

SEC. 7, T 8 N - R 7 E

STA. 34+42

RR STA. 3514+27

& FARM RD.

2701' R

SPAN "A"

REL. #22103

PLF

FARM RD.

STA. 37+23

RR STA. 3517+08

& FARM RD.

(20' W.)

PLF

PLF


PLF



SEC. 7 & 18, T 8 N - R 7 E

STA 38+12
END R/W CLEARING

STA 38+12
BEG. 1455 R/W
CLEARING

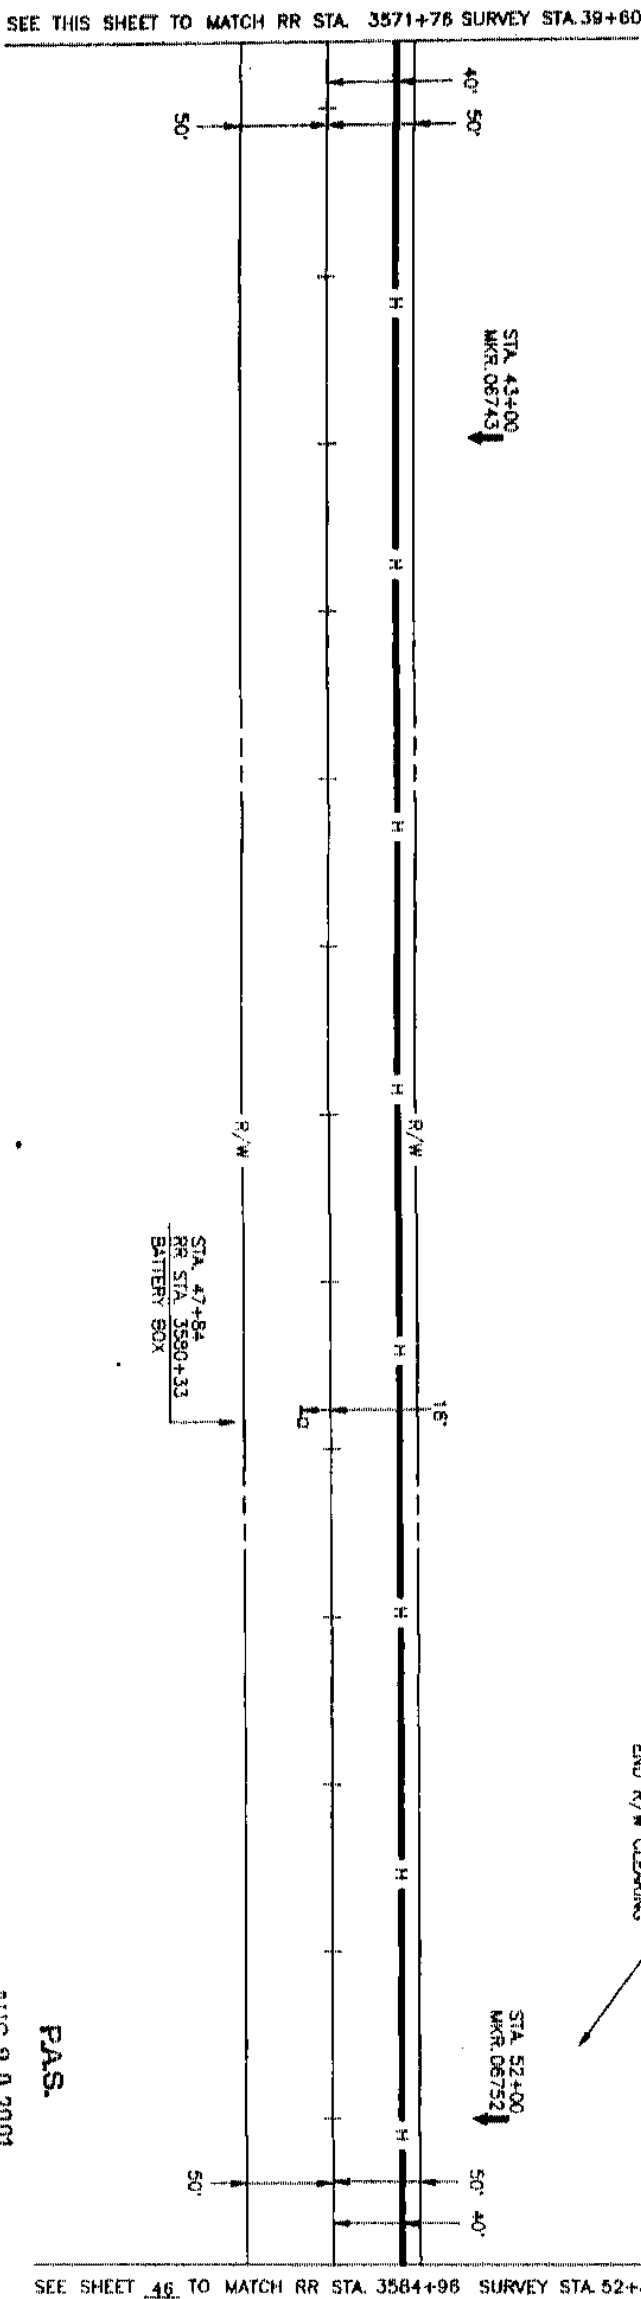


AUG 20 2001

[illegible]

LINCOLN TELEPHONE CO. LINCOLN, NE

LANCASTER CO., NE
SALTILLO TWP.
SEC. 18 & 19, T 8 N - R 7 E


SEE SHEET 46 TO MATCH RR STA. 3611+84 SURVEY STA. 26+68

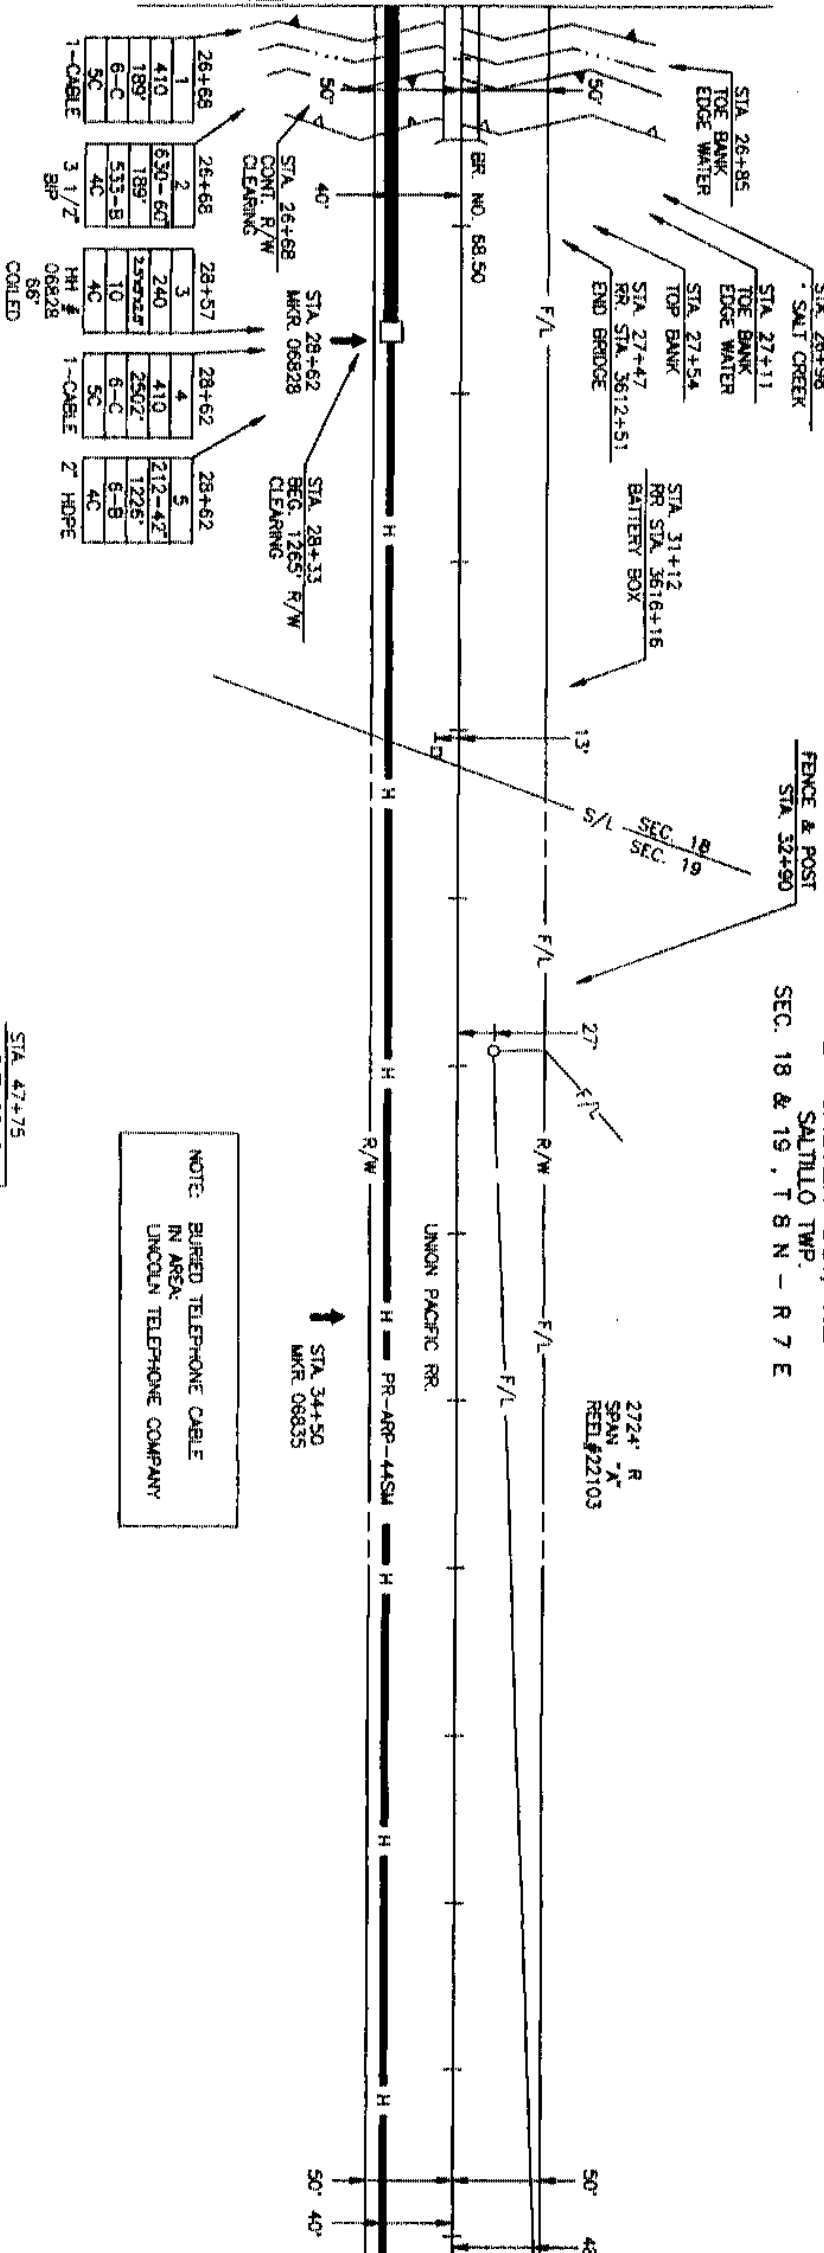

SEE THIS SHEET TO MATCH RR STA. 3625+12 SURVEY STA. 40+16

NOTE: BURIED TELEPHONE CABLE
IN AREA
LINCOLN TELEPHONE COMPANY

SEE THIS SHEET TO MATCH RR STA. 3625+12 SURVEY STA. 40+16

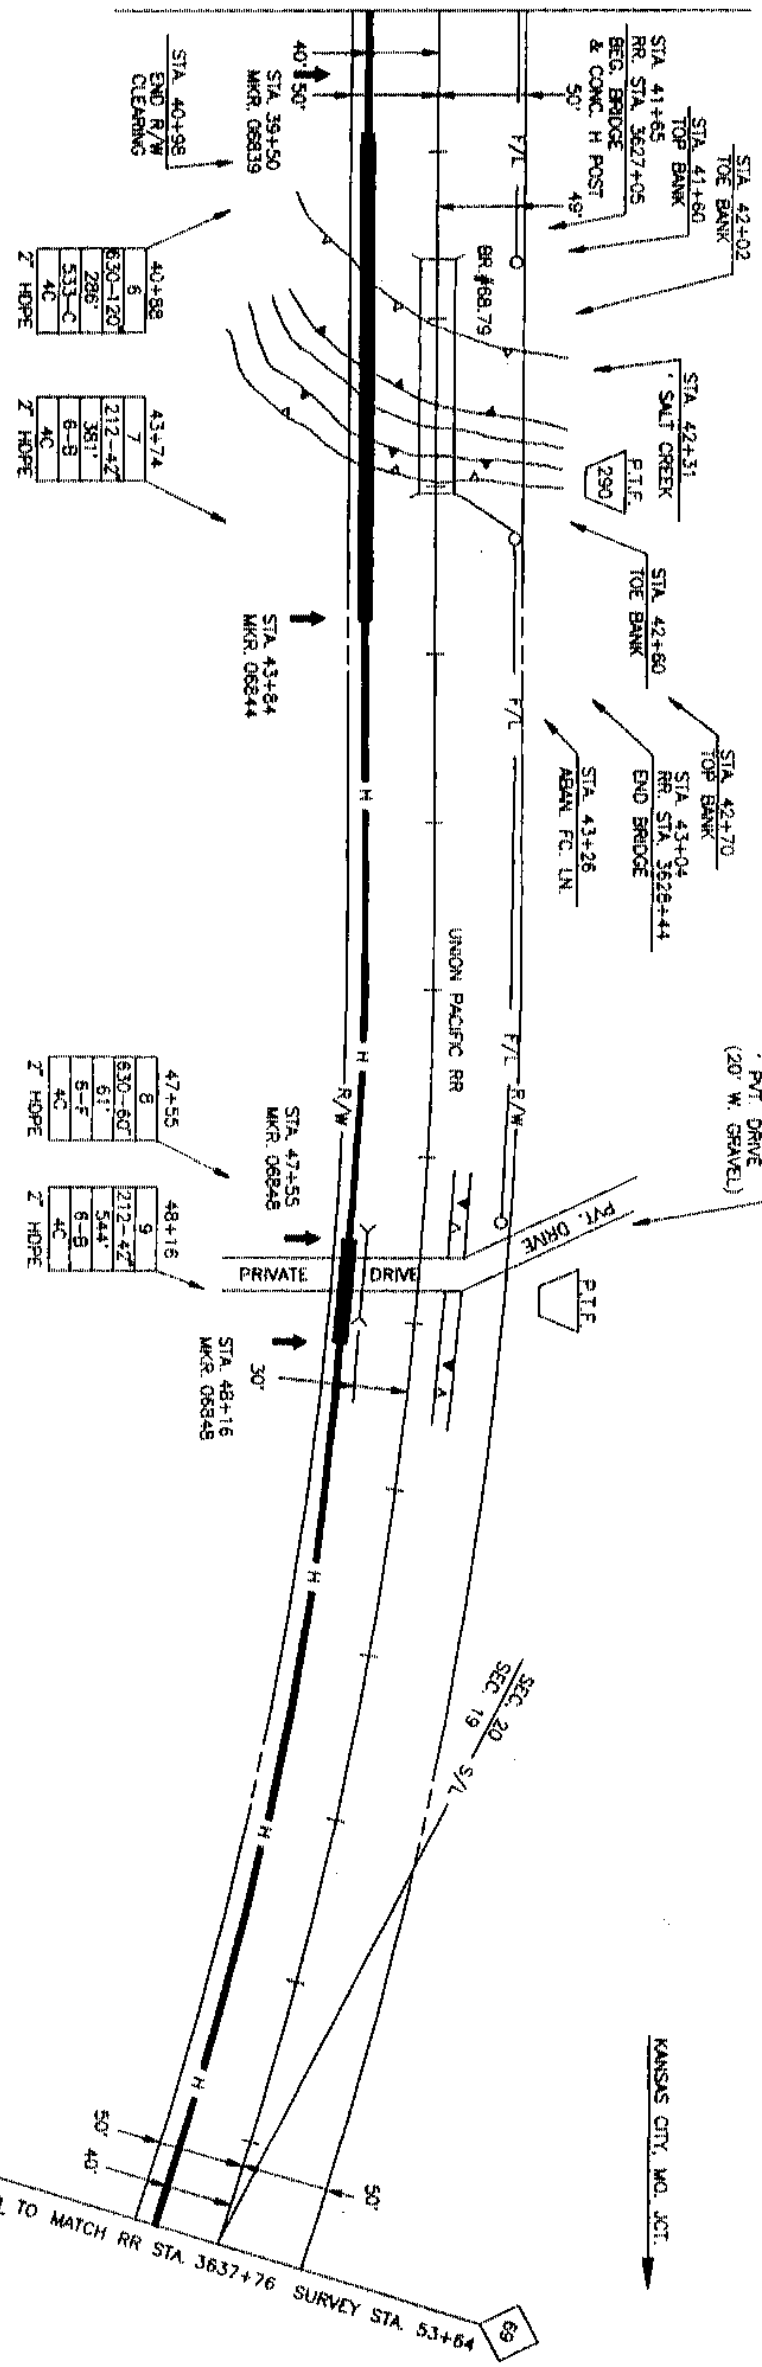

SEE SHEET 48 TO MATCH RR STA. 3637+76 SURVEY STA. 53+64



PROJECT # 05660

SPAN: 1" A

KANSAS CITY, MO. JCT

LINCOLN, NE

MAP FOOTAGE

SURVEY 2696

RAILROAD 2640

MATERIAL LIST QUANT

CABLE 2724

1 1/2" CORR. ROD

1 1/2" CORR. ROD

MCI

TELECOMMUNICATIONS CORPORATION

TITLE: FIBER OPTIC CABLE ROUTE

KANSAS CITY, MO. JCT TO LINCOLN, NE

ENGINEER JEFFREY

REVISIONS

DATE

DESCRIPTION

BY

DATE

DESCRIPTION

BY

P.A.S.

AUG 20 2001

SCALE	HORIZONTAL: 1" = 50'
VERTICAL: 1" = 50'	
DEPT. ID.	LOC. ID. 0
MP 58.10 MP 59	
SHEET 47 OF 557	
05660047.01A	

LINCOLN, NE

LANCASTER CO., NE.

SALTILLO TWP.

SEC. 19 & 20, T 8 N - R 7 E

STA. 8+00
RR STA. 3645+03
30' C.I.P. CULV.

2691' R
SPAN "A"
REEL #22103

0+00	0+00
1	2
410	212-47
1990'	1990'
5-C	6-B
5C	4C
1-CABLE	2' HDPE

SEE SHEET 47 TO MATCH RR STA. 3657+76 SURVEY STA. 0+00

SEE THIS SHEET TO MATCH RR STA. 3650+86 SURVEY STA. 13+20

STA. 13+72
RR STA. 3658+72
FARM RD.
(20' W.)

STA. 16+74
RR STA. 3657+74
30' C.I.P. CULV.
DRAIN (6' WIDE X 5' DEEP)

STA. 17+02
RR STA. 3656+02
WHISTLE POST

P.I.E.
7354

NOTE: OVERHEAD NO. PAC. X-ING.
REMOVED & ABANDONED @ STA. 26+00.
REMAINING TRESSLE POLES ARE TO
BE REMOVED

KANSAS CITY, MO. JCT.

SEE THIS SHEET TO MATCH RR STA. 3650+96 SURVEY STA. 13+20

SEE SHEET 49 TO MATCH RR STA. 3664+16 SURVEY STA. 28+40



PROJECT # 05666

SPAN: "A"

KANSAS CITY, MO. JCT.

TO
LINCOLN, NE

MAP FOOTAGE

SURVEY 2640

RAILROAD 2640

MATERIAL LIST QUANT

CABLE 2691'

4' PVC 2691'

11/2" CORE IND. 11/2" CORE IND.

4' SPLIT GP 4' SPLIT GP

4' SPLIT PAC 4' SPLIT PAC

4' SPLIT GP 4' SPLIT GP

4' SPLIT PAC 4' SPLIT PAC

4' SPLIT GP 4' SPLIT GP

DATE: 05660048 01A

MCI

TELECOMMUNICATIONS CORPORATION

TITLE: FIBER OPTIC CABLE ROUTE

KANSAS CITY, MO. JCT. TO LINCOLN, NE.

ENGINEER: JEFFREY

DATE: 05660048 01A

REVISIONS:

DATE: 05660048 01A

DESCRIPTION:

DATE: 05660048 01A

BY:

DATE: 05660048 01A

DESCRIPTION:

DATE: 05660048 01A

BY:

DATE: 05660048 01A

DESCRIPTION:


DATE: 05660048 01A

BY:

DATE: 05660048 01A

DESCRIPTION:

DATE: 05660048 01A

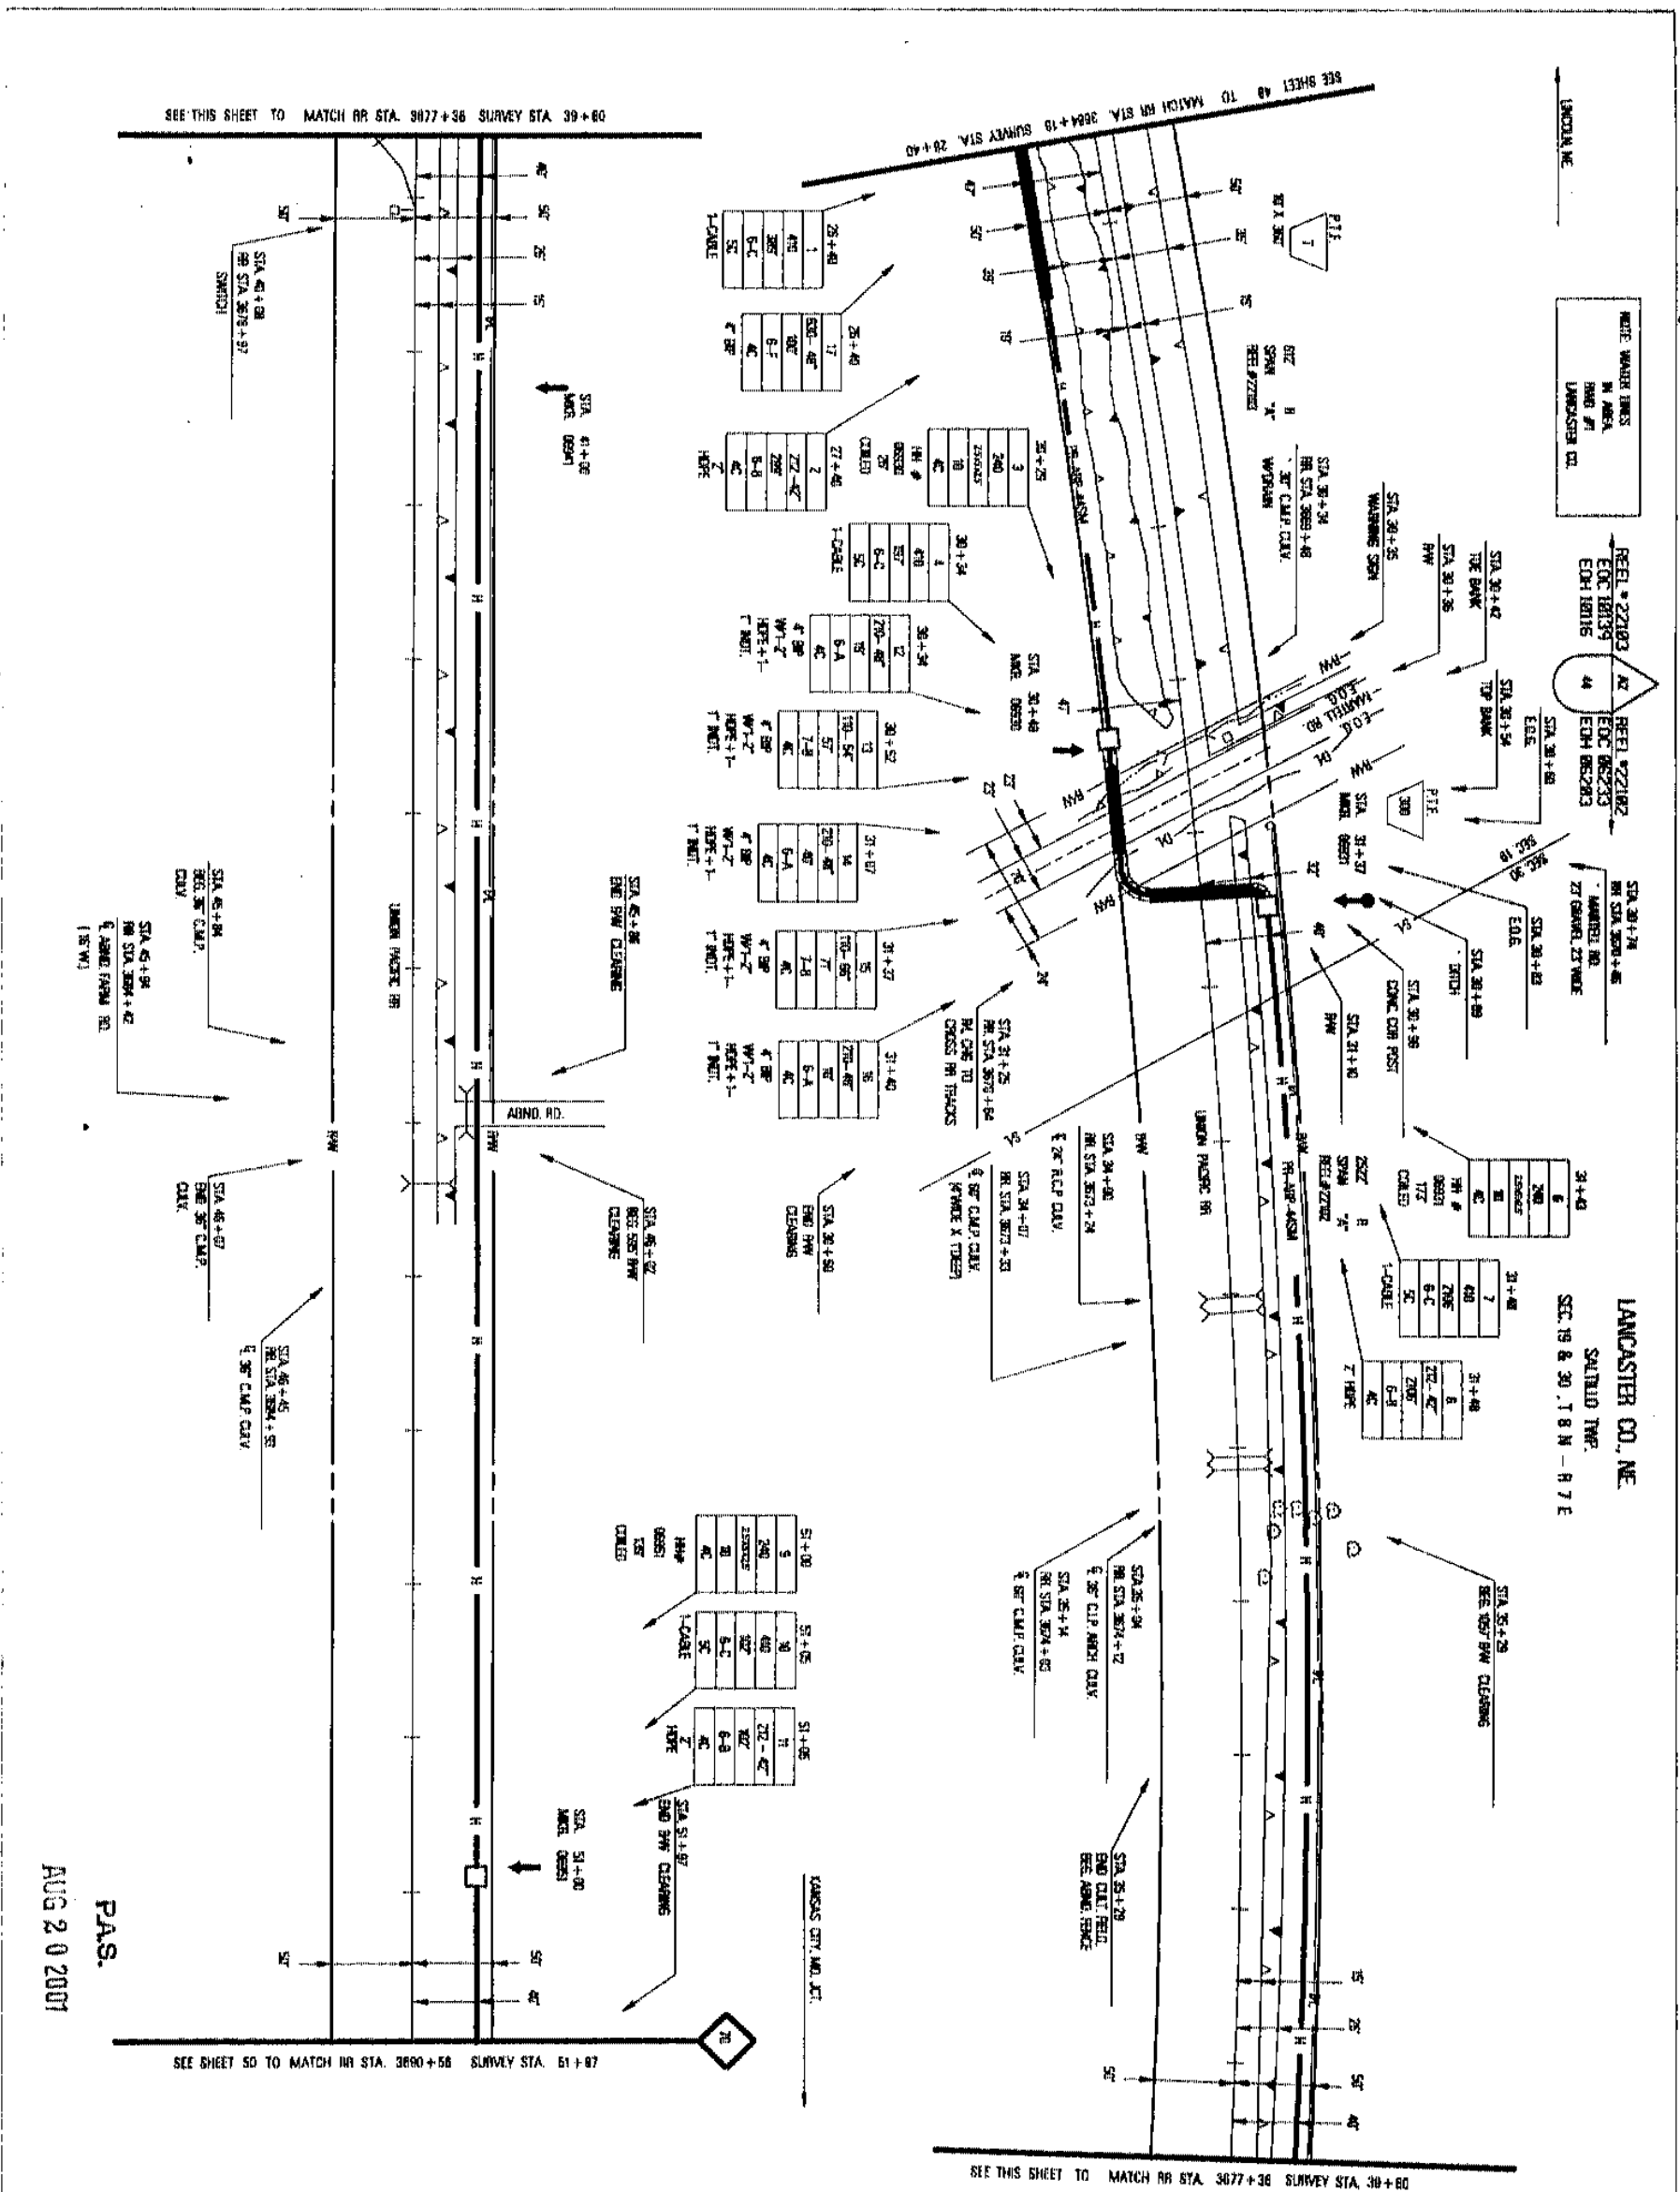[illegible]



PROJECT: # 05660

SPAN: 1"

KANSAS CITY, MO. JC

TO LINCOLN, NE

MAP FOOTAGE

SURVEY 2640

RAILROAD 2640

MATERIAL LIST (QUAN

CABLE 2755

4" GP

4" PAC

11/4 CORR. MOT.

4" SPLIT GP

HH 3" x 5" x 4"

BLR. CA. MARKS 6

10M STRAND

4" BP

2" HOPE 2755

1" NOT.

MCI

TELECOMMUNICATIONS CORPORATION

TITLE: FIBER OPTIC CABLE ROUTE
KANSAS CITY, MO. JCT. TO LINCOLN, NE

DATE

ENGINEER JEFFREY

REVISIONS

DATE DESCRIPTION

1-93 DIRECTIONAL BORE

1-94 AS-BUILT

1-94 AS-BUILT

SCALE

HORIZONTAL: 1" = 50'

VERTICAL: 1" = 50'

DEPT. ID. LOC. ID. 04

MP 20 TO MP 21


SHEET 50 OF 557

DATE 05/6/00 050.01A

LANCASTER CO., NE.
SALTILLO TWP.
SEC. 30, T 8 N - R 7 E


2755' R
SPAN "A"
REEL#22102

SEE SHEET 49 TO MATCH RR STA. 3680+56 SURVEY STA. 0+00

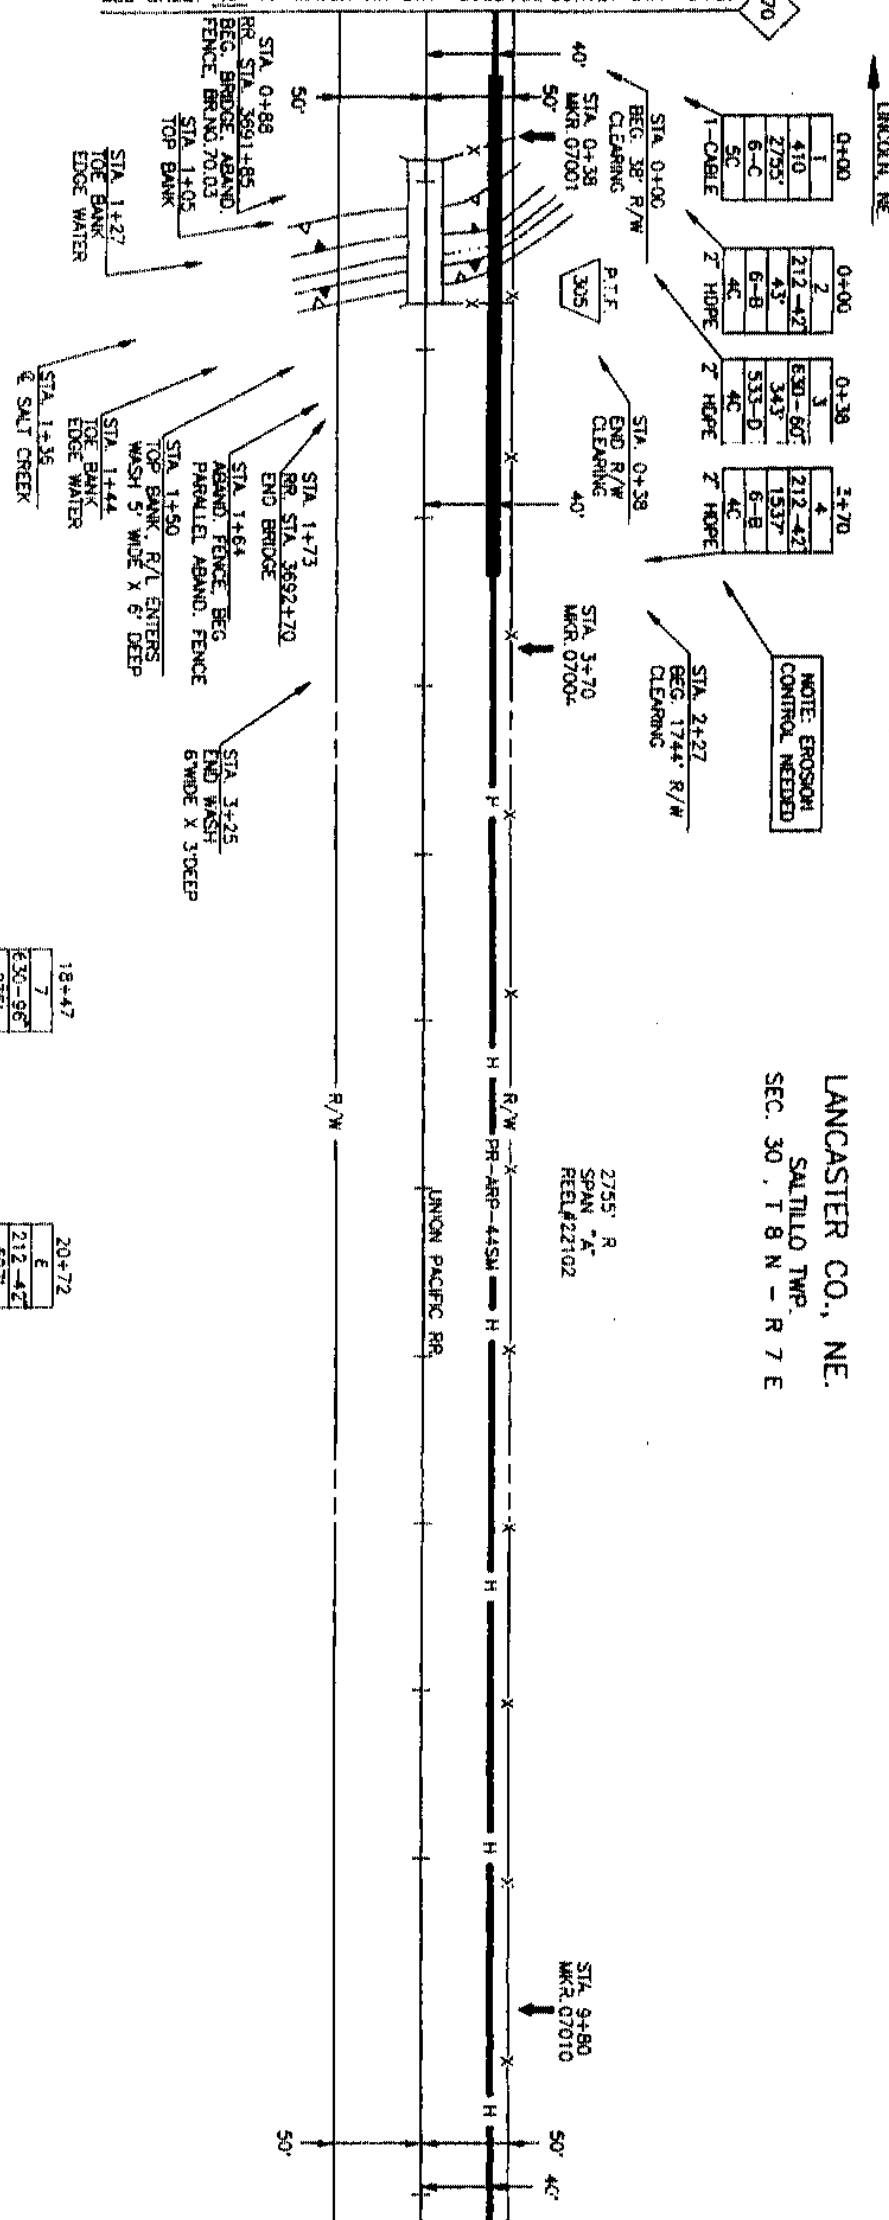

SEE THIS SHEET TO MATCH RR STA. 3703+76 SURVEY STA. 13+20

SEE THIS SHEET TO MATCH RR STA. 3703+76 SURVEY STA. 13+20

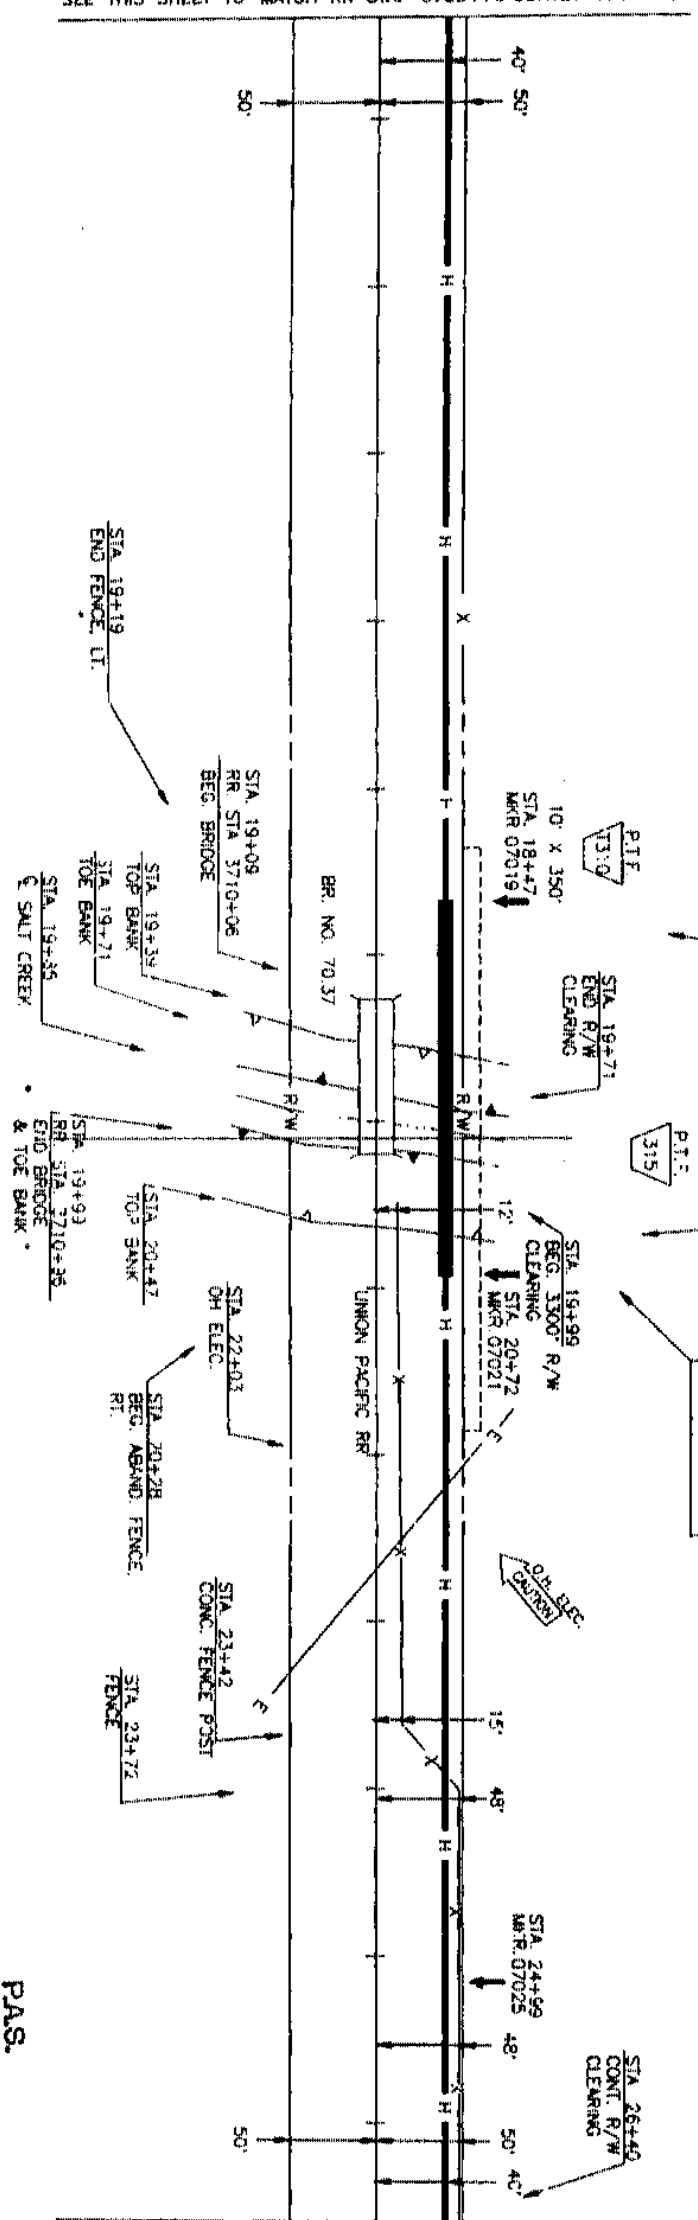

SEE SHEET 51 TO MATCH RR STA. 3716+96 SURVEY STA. 26+40

P.A.S.
AUG 20 2001

LANCASTER CO., NE

SEC. 30 & 31, T 8 N - R 7 E



SPAN: 75

TO

NO. 100146E
SURVEY 2659

MATERIAL	LIST	QUAN
CABLE		

4 PVC	
-------	--

4" SPLIT PVC

BUR, CA. MKRS.

1	2	3	100
---	---	---	---	---	---	---	---	---	----	----	-----

INDT.	19
-------	----

1

CON

DR
ROU
NE

COM
ELE
COM

ION
C

M
NIC
O
ICT

OM
FIB

TEL: 011 222 222 2222

TI
K

ENGINEER JEFFREY
DEVISIONS

RS-OUT	
--------	--

CONFIDENTIAL

THE UNIVERSITY OF CHICAGO PRESS

CASE

VERTICAL: $1^{\circ} = 50'$

MP 70 TO MP 71

05660051.01A


1

MCI

TELECOMMUNICATIONS CORPORATION

TITLE: FIBER OPTIC CABLE ROUTE

KANSAS CITY, MO. JCT. TO LINCOLN, NE.

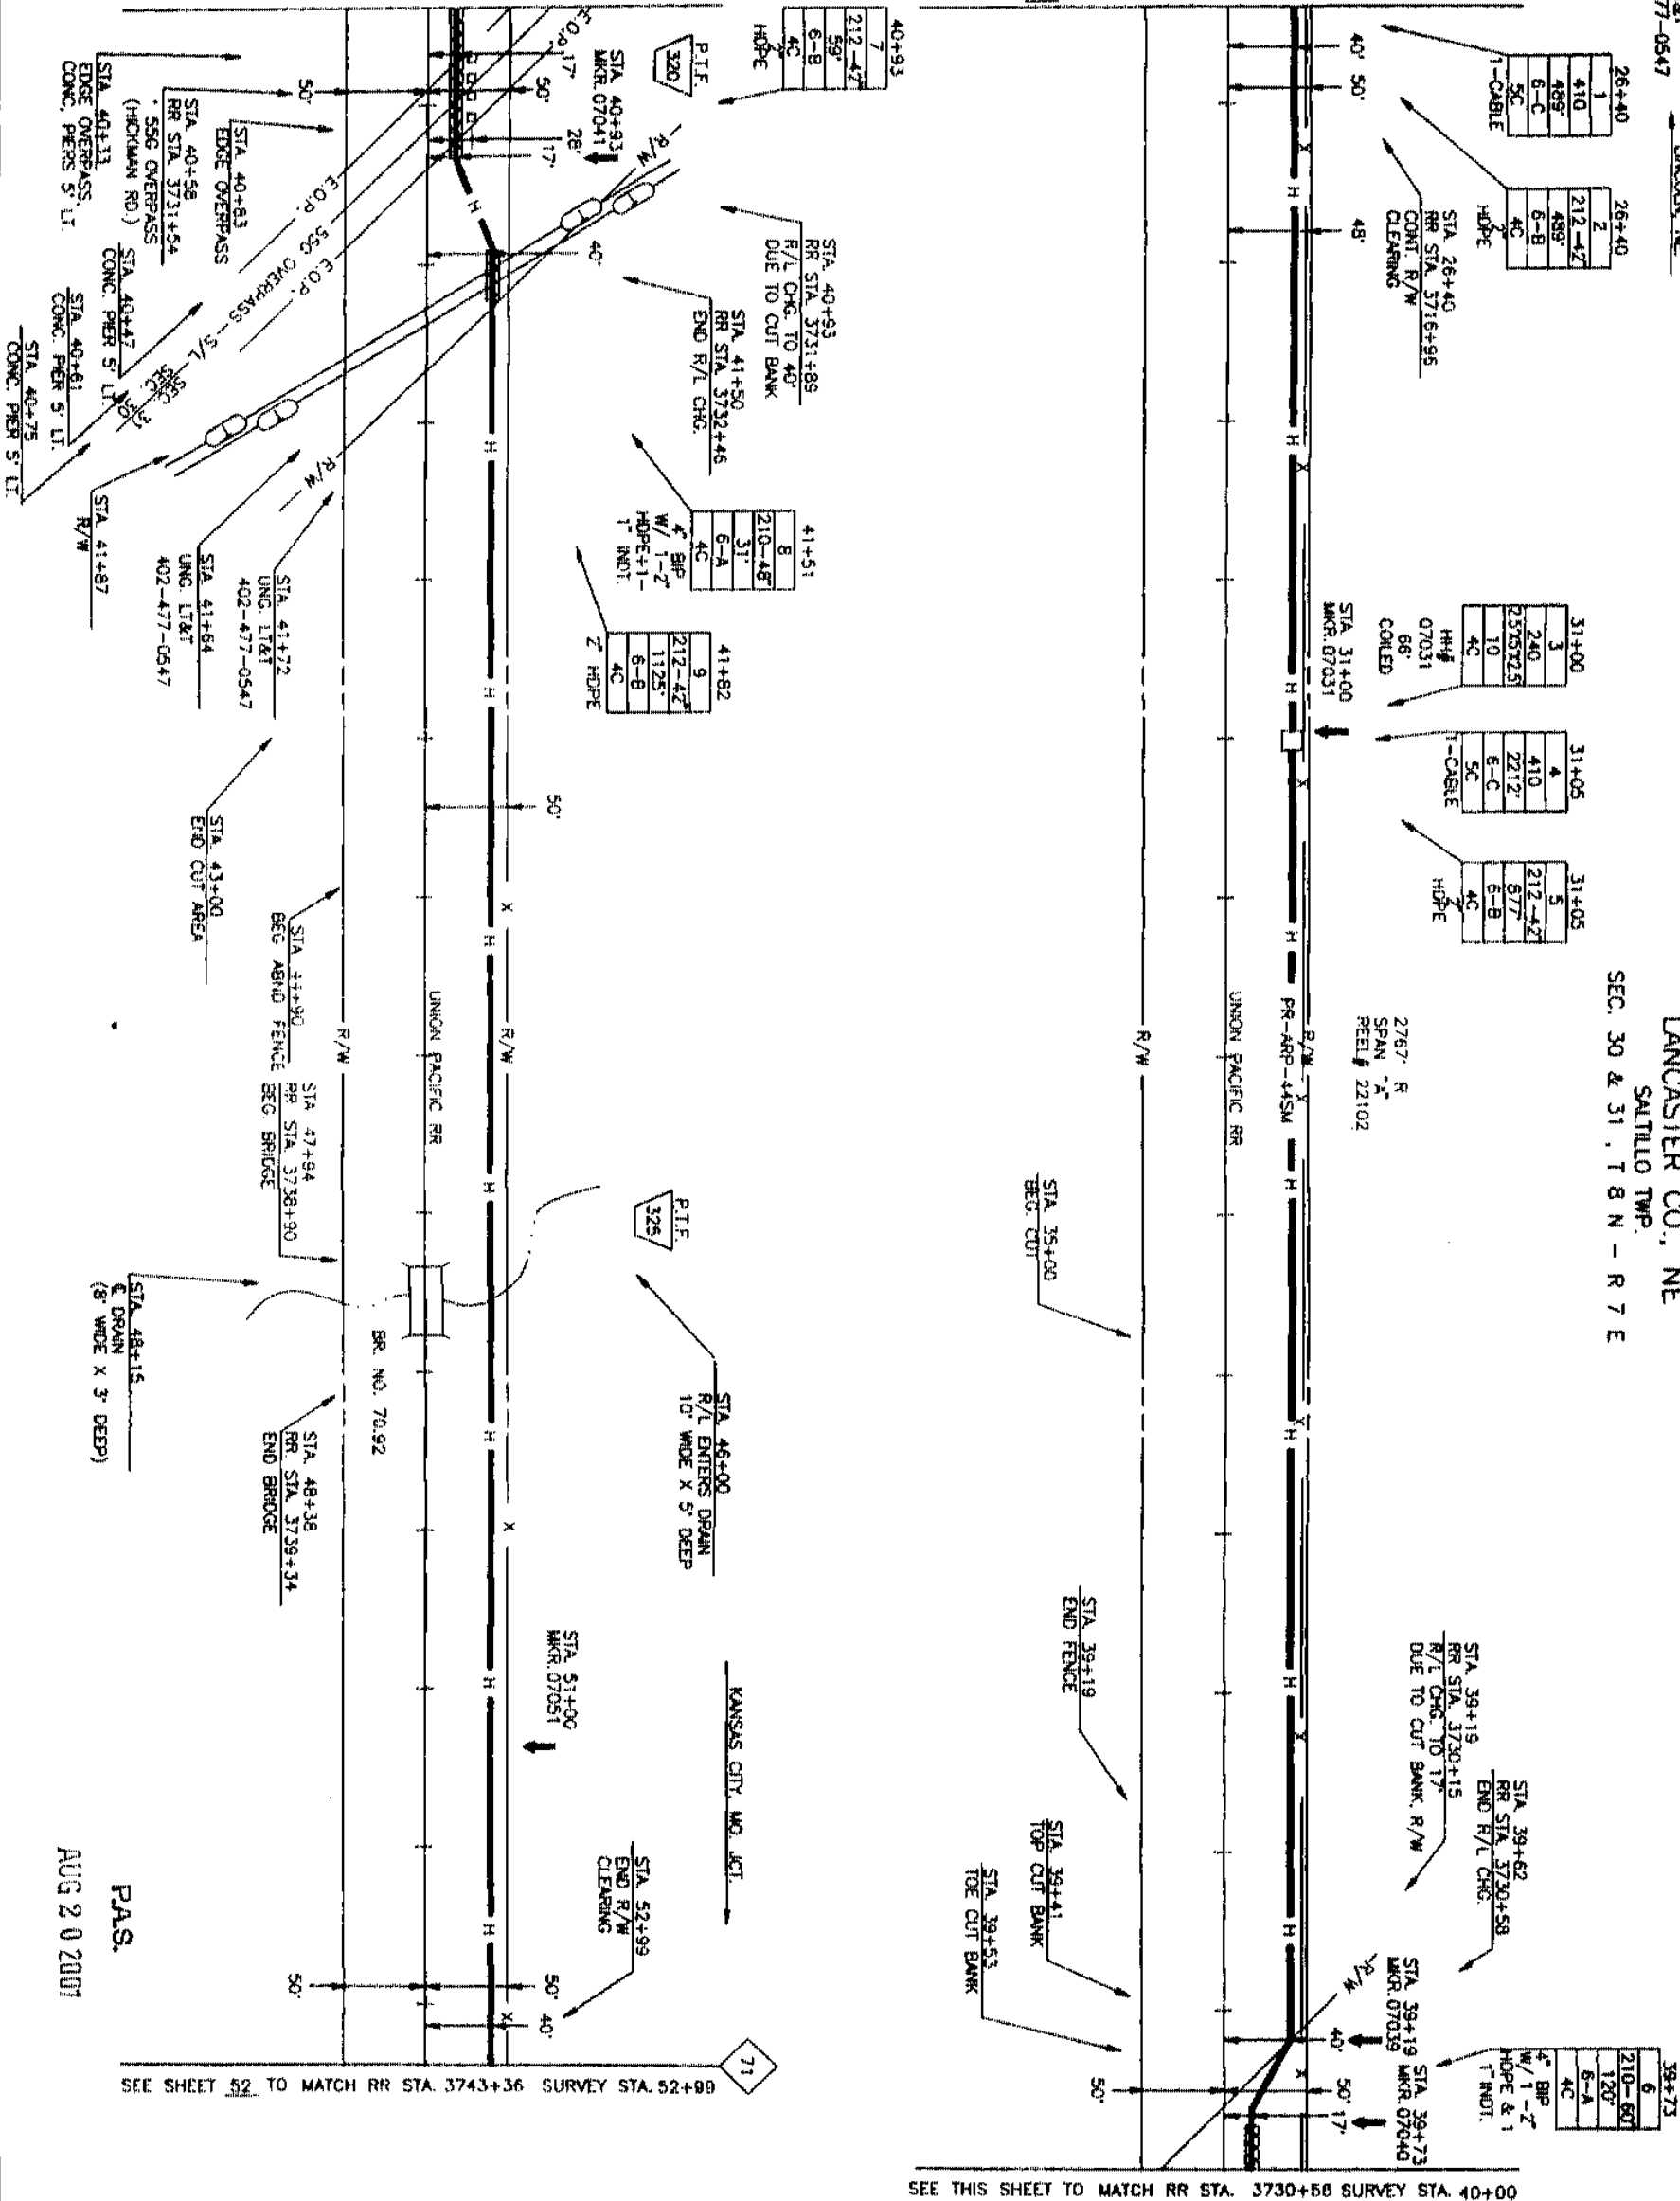

SEE THIS SHEET TO MATCH RR STA. 3730+58 SURVEY STA. 40+00

SEE SHEET 52 TO MATCH RR STA. 3743+36 SURVEY STA. 52+00

P.A.S.

AUG 20 2005

SCALE

TOTAL: 1 = 58
1 = 50

LOC:ID:G

70 10 MP 71

51 OF 557

SECRET

060305 1:01A

UNION ONE-CAL
1-402-477-0547

LANCASTER CO., NE.

SALTILLO, CENTERVILLE TWP.
SEC. 31 & 36, T 8 N - R 7 E, T 8 N - R 6 E



PROJECT # 05660

SPAN: 1

KANSAS CITY, MO. JC

TO
LINCOLN, NE.

MAP FOOTAGE

SURVEY 2640

RAILROAD 2640

MATERIAL LIST (QUAN)

CABLE 2774

11/4" CORR. MDT

11/4" CORR. MDT

MCI

TELECOMMUNICATIONS CORPORATION

TITLE: FIBER OPTIC CABLE ROUTE

KANSAS CITY, MO. JCT. TO LINCOLN, NE.

DATE

ENGINEER

REVISIONS

DATE

DESCRIPTION

DATE

DESCRIPTION

SCALE

HORIZONTAL: 1" = 50'

VERTICAL: 1" = 50'

DEPT. ID. LOC. ID. 04

MP 71 TO MP 72

SHEET 52 OF 557

DATE


05660052.01A

SEE SHEET 51 TO MATCH RR STA. 3745+36 SURVEY STA. 0+00

SEE THIS SHEET TO MATCH RR STA. 13+20 SURVEY STA. 3756+56

SEE THIS SHEET TO MATCH RR STA. 3756+56 SURVEY STA. 13+20

SEE SHEET 53 TO MATCH RR STA. 3769+76 SURVEY STA. 26+40

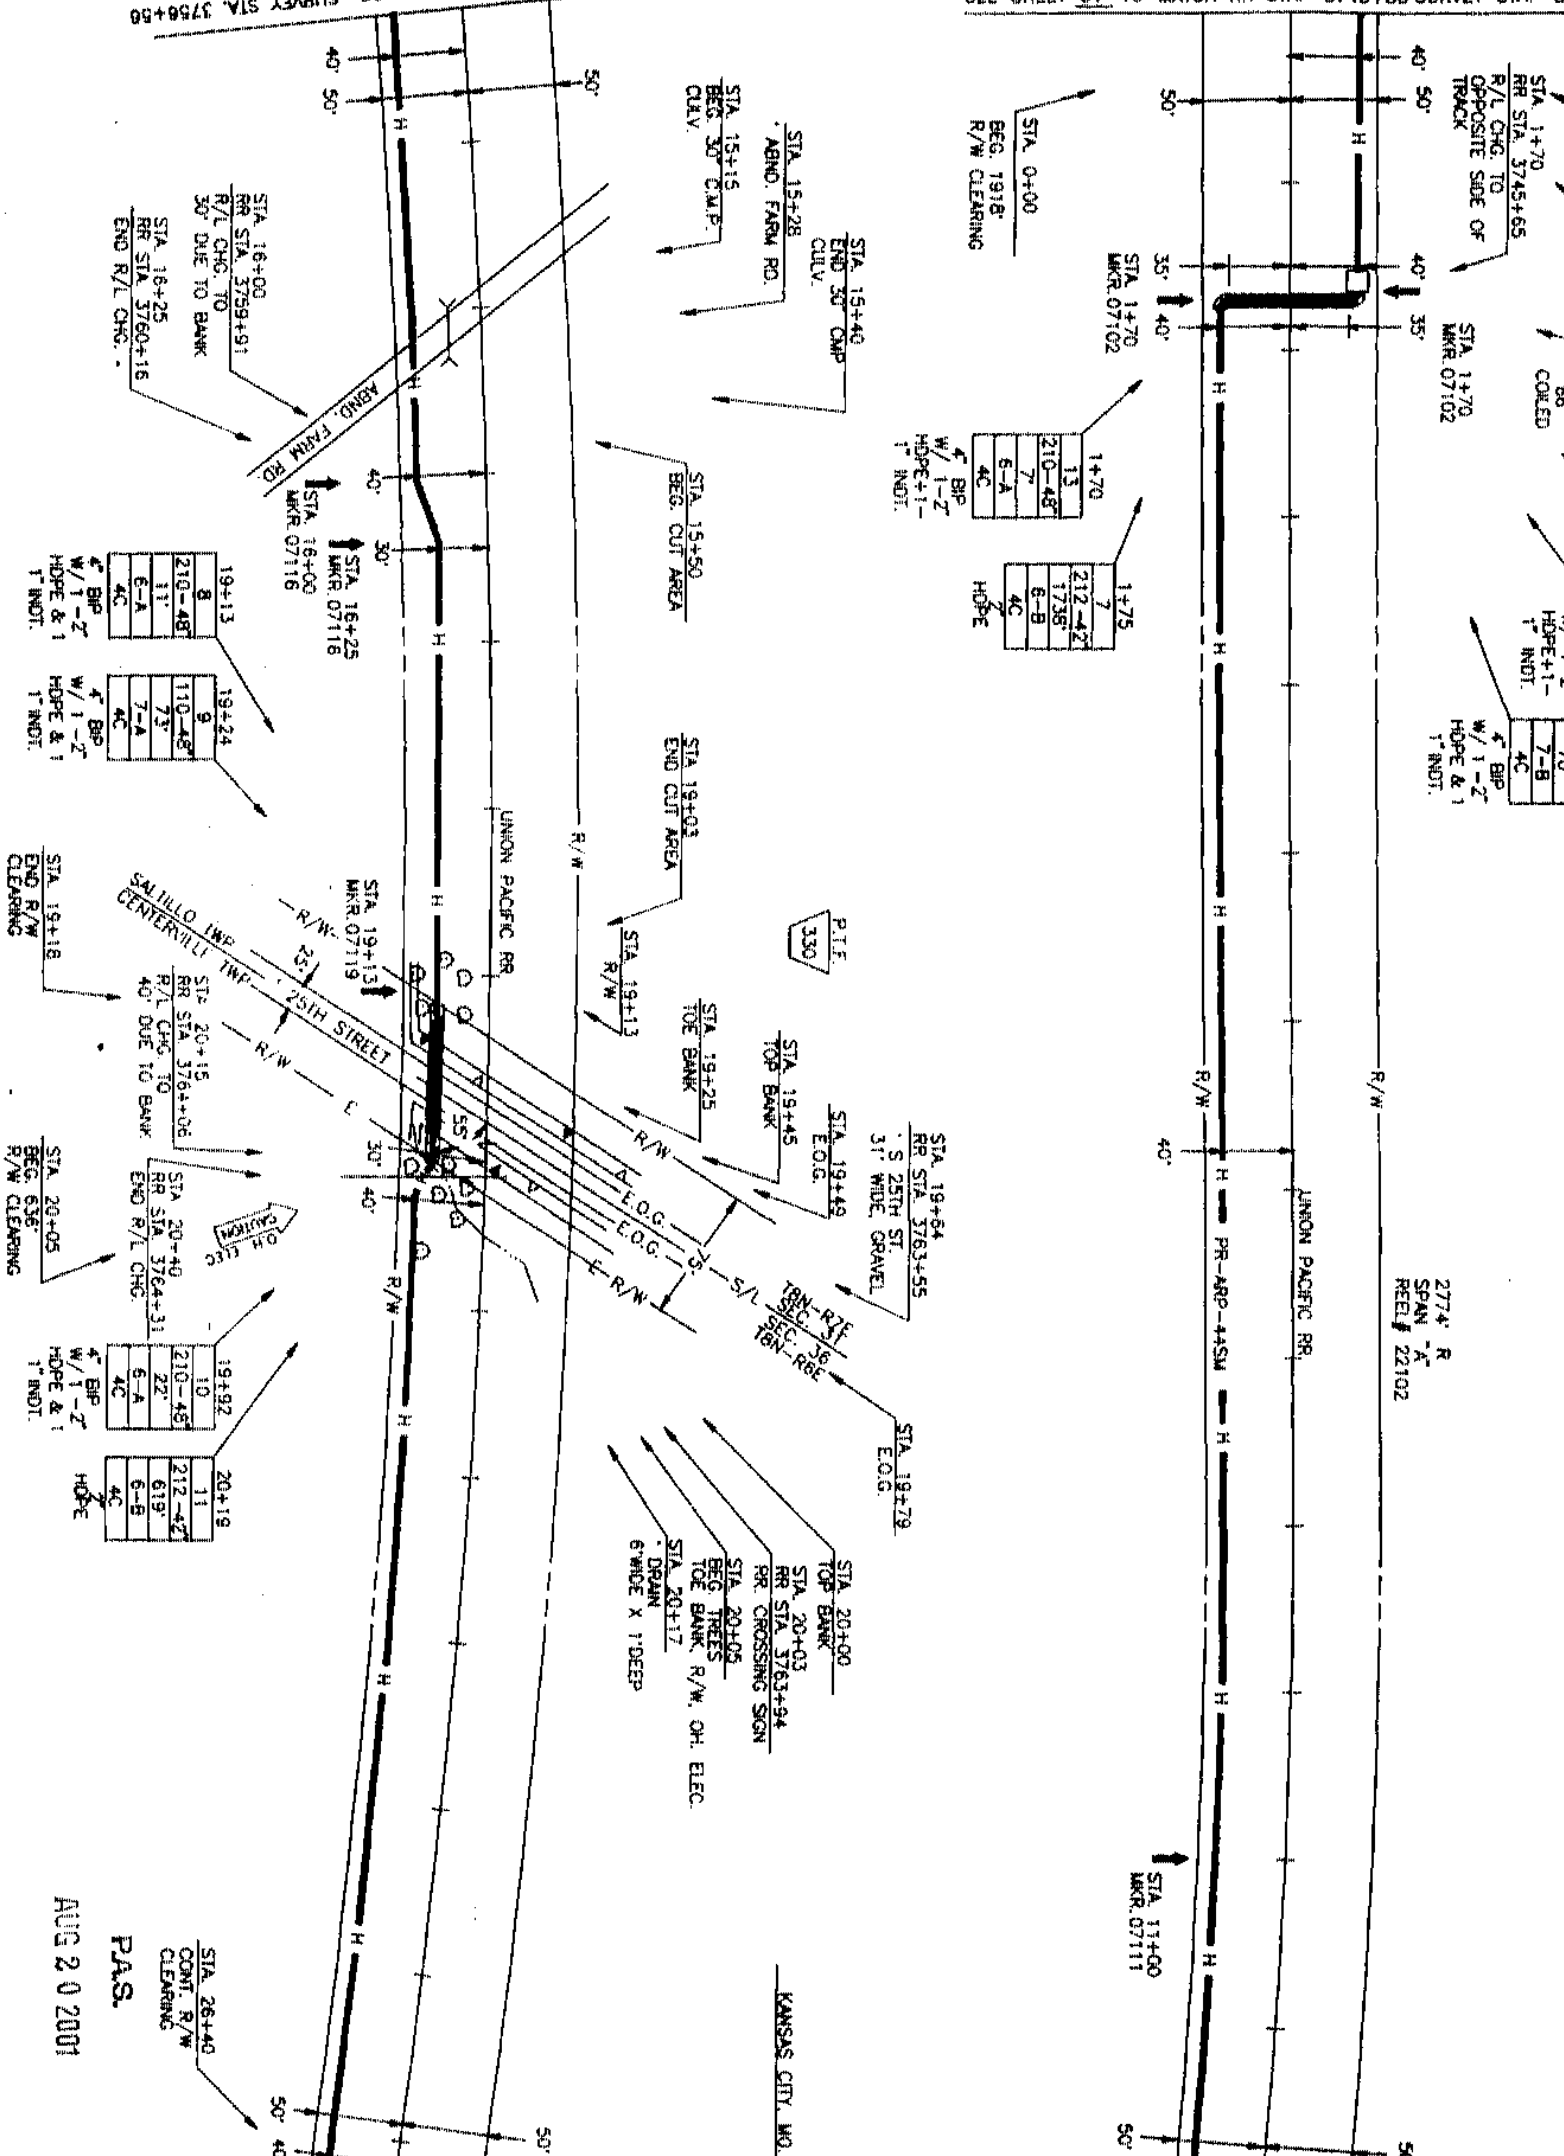

LANCASTER CO., NE
CENTERVILLE TWP.
SEC. 36, T 8 N - R 6 E



PROJECT: 09660

SPAN: 7

KANSAS CITY, MO. JCT.

TO
LINCOLN, NE.

MAP FOOTAGE

SURVEY 2642

RAILROAD 2640

MATERIAL LIST (QUM)

CABLE

2745

4" GP

11/2" CORR. NOT.

4" SPLIT GP

4" SPLIT PVC

1H 3" x 5" x 4"

1H 4" x 4" x 4"

BLUR. CA. UNRS.

10M STRAND

10 STEEL CASSING

4" BHP

2" HDPE

1H 2.5X5X2.5

1

2862

2862

MCI
TELECOMMUNICATIONS CORPORATION

TITLE: FIBER OPTIC CABLE ROUTE
KANSAS CITY, MO. JCT. TO LINCOLN, NE.

DATE

ENGINEER

REVISIONS

DATE

DESCRIPTION

1-01 RR STA

1-01 AS-BUILT

1-01 AS-BUILT


1-01 AS-BUILT

SEE SHEET 54 TO MATCH RR STA. 3786+16 SURVEY STA. 52+82

SEE THIS SHEET TO MATCH RR STA. 3782+84 SURVEY STA. 39+60

AUG 20 2001
P.A.S.

SEE THIS SHEET TO MATCH RR STA. 3782+84 SURVEY STA. 39+60

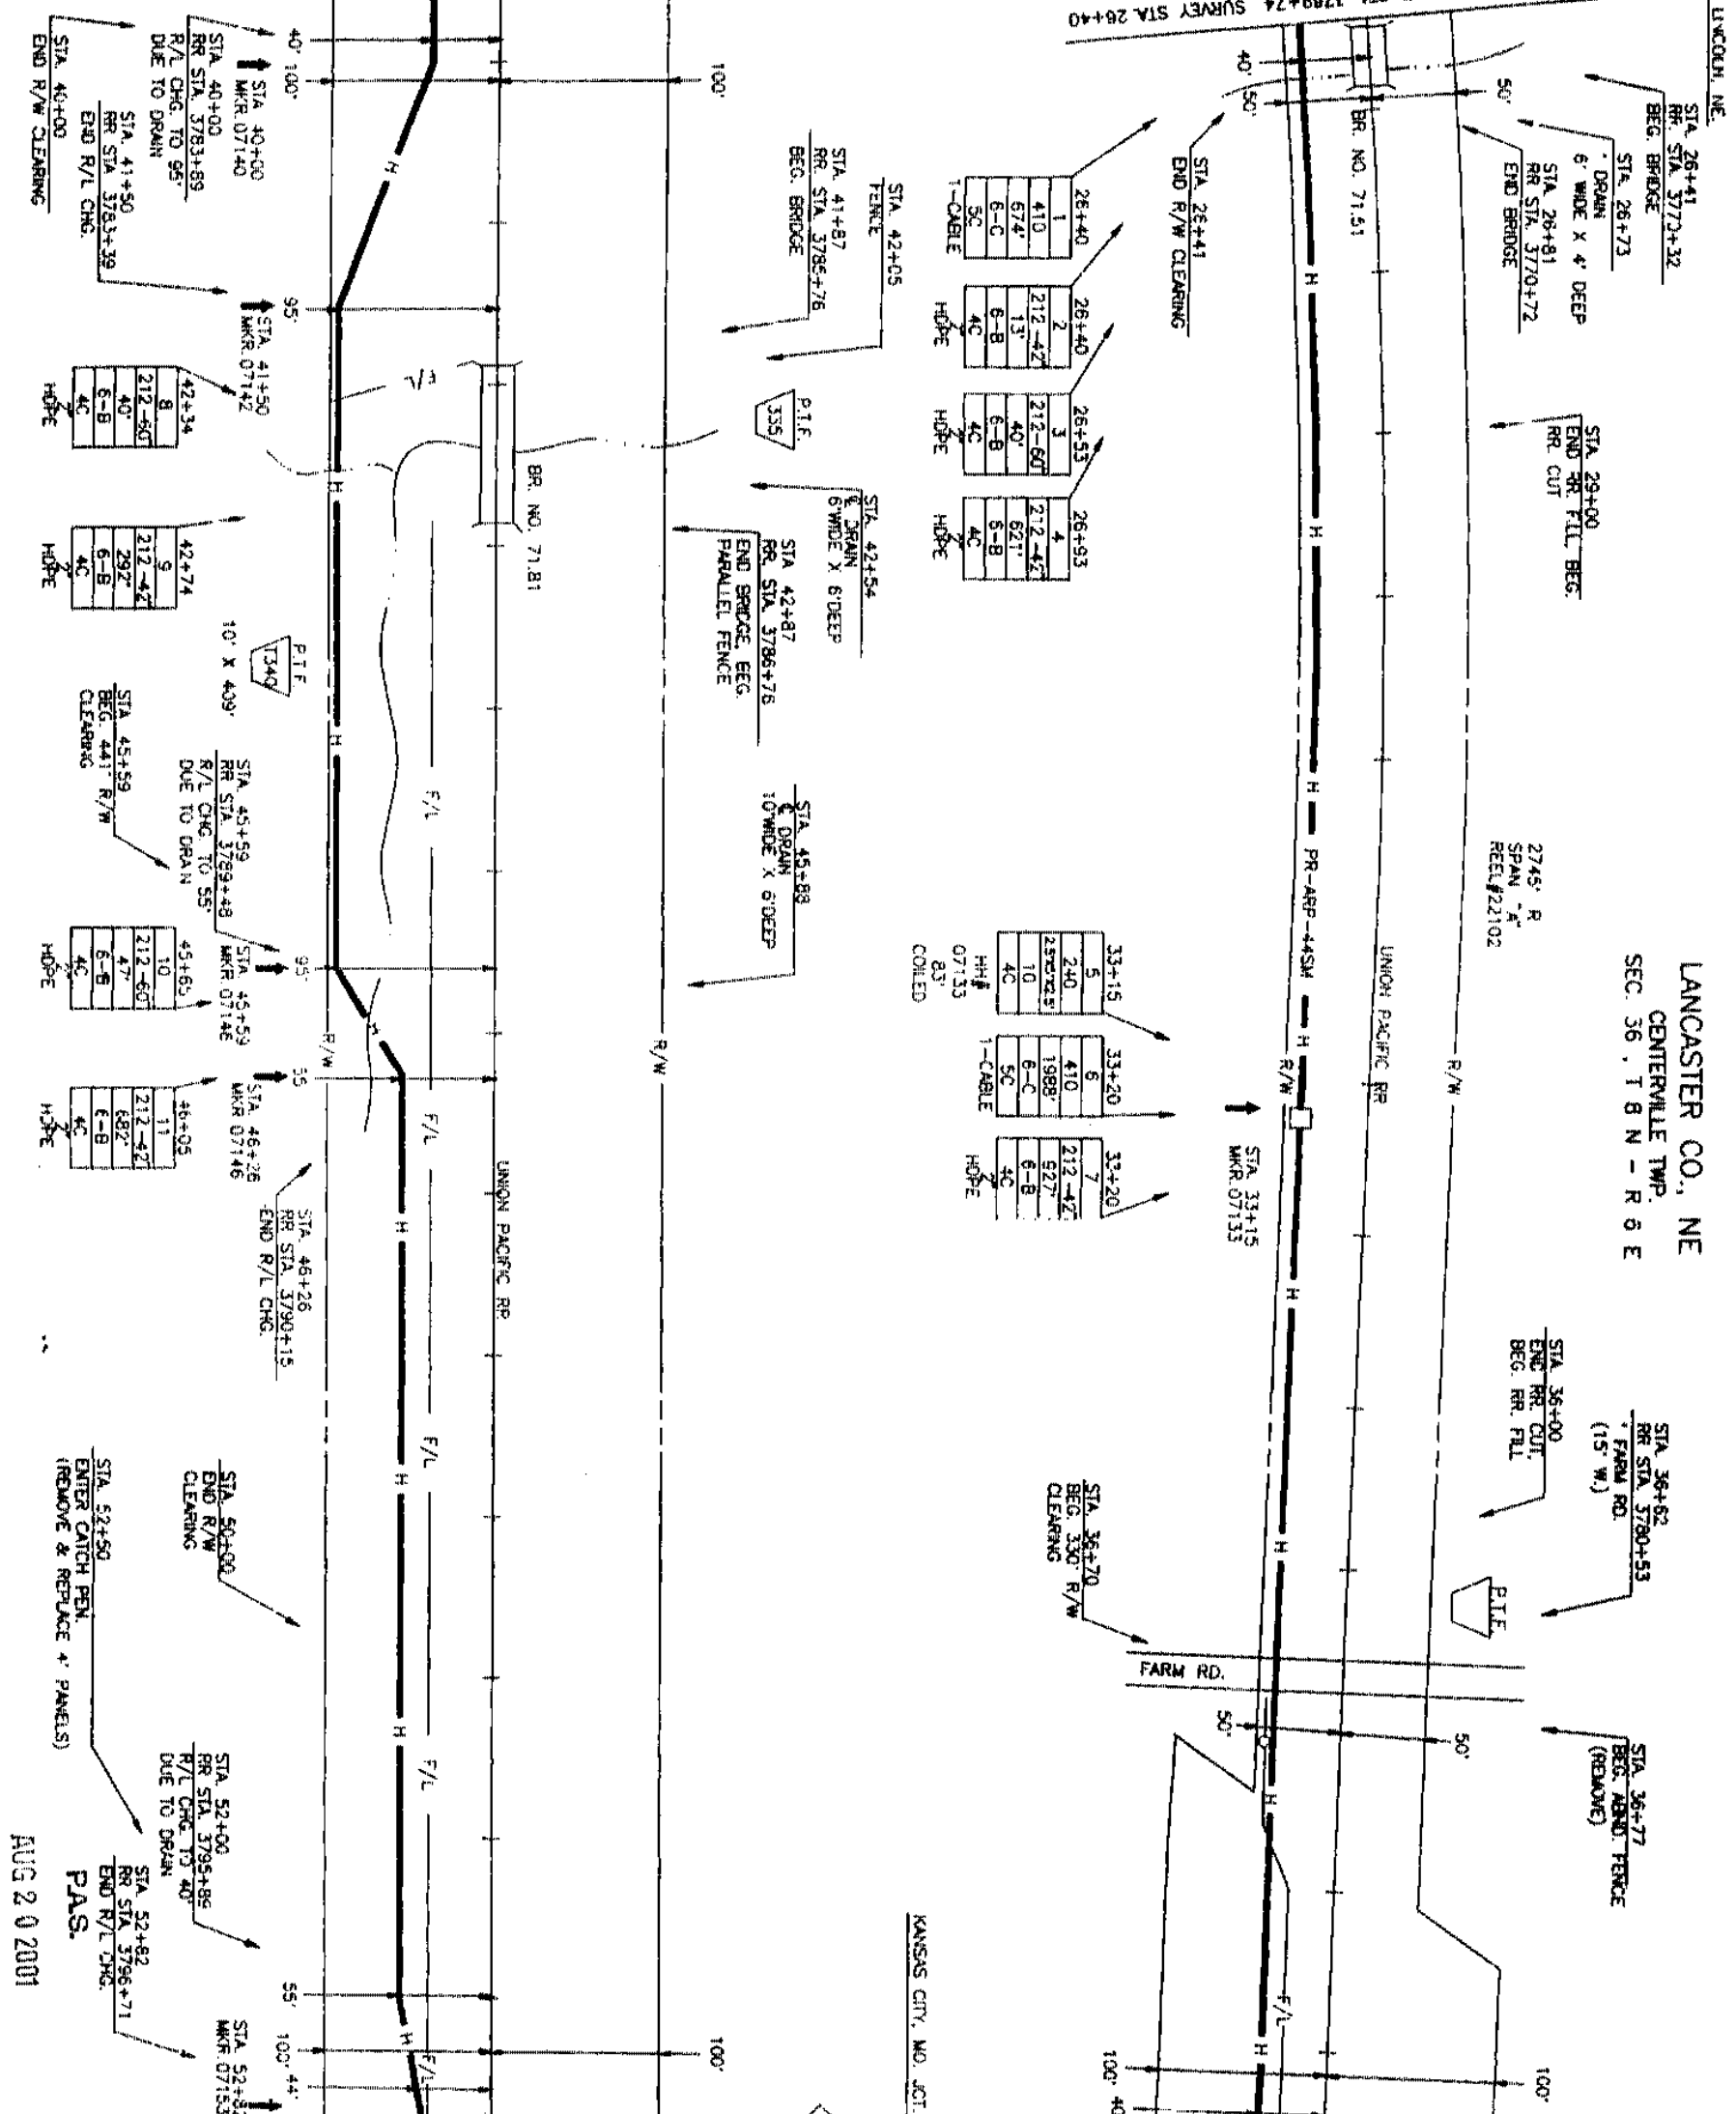

SCALE	HORIZONTAL: 1" = 50'
VERTICAL: 1" = 50'	
DEPT. ID.	LOC. ID. 04
MP 71 TO MP 72	
SHEET 53 OF 557	
05660053.014	

LANCASTER CO., NE.
BUDA TWP.
SEC. 1, T 7 N - R 6 E



PROJECT # 05660

SPAN: "A"

KANSAS CITY, MO. JCT.
TO
LINCOLN, NE.

MAP FOOTAGE
SURVEY 2651

RAILROAD 2640

MATERIAL LIST 0004

CABLE 272

4" PVC 272

1 1/2" CORR. BOLT 4

4" SPLIT PVC 4

4" x 4" x 4" 4

4" x 4" x 4" 4

BUR. CA. MARKS 1

10M STRAND 10 STEEL CLOSING

2" HDPE 266

1H. 2.5'x5'x2.5' 1

MCI

TELECOMMUNICATIONS CORPORATION

TITLE: FIBER OPTIC CABLE ROUTE

KANSAS CITY, MO. JCT. TO LINCOLN, NE.

DATE

ENGINEER JEFFREY

REVISIONS

DATE	DESCRIPTION	BY
1-23-88	RR STA.	C
1-24-88	AS BUILT	T

SCALE

HORIZONTAL: 1" = 50'


VERTICAL: 1" = 50'

DEPT. ID. LOC. ID. 04

MP 72 TO MP 73

SHEET 55 OF 557


DATE 05660055.01A

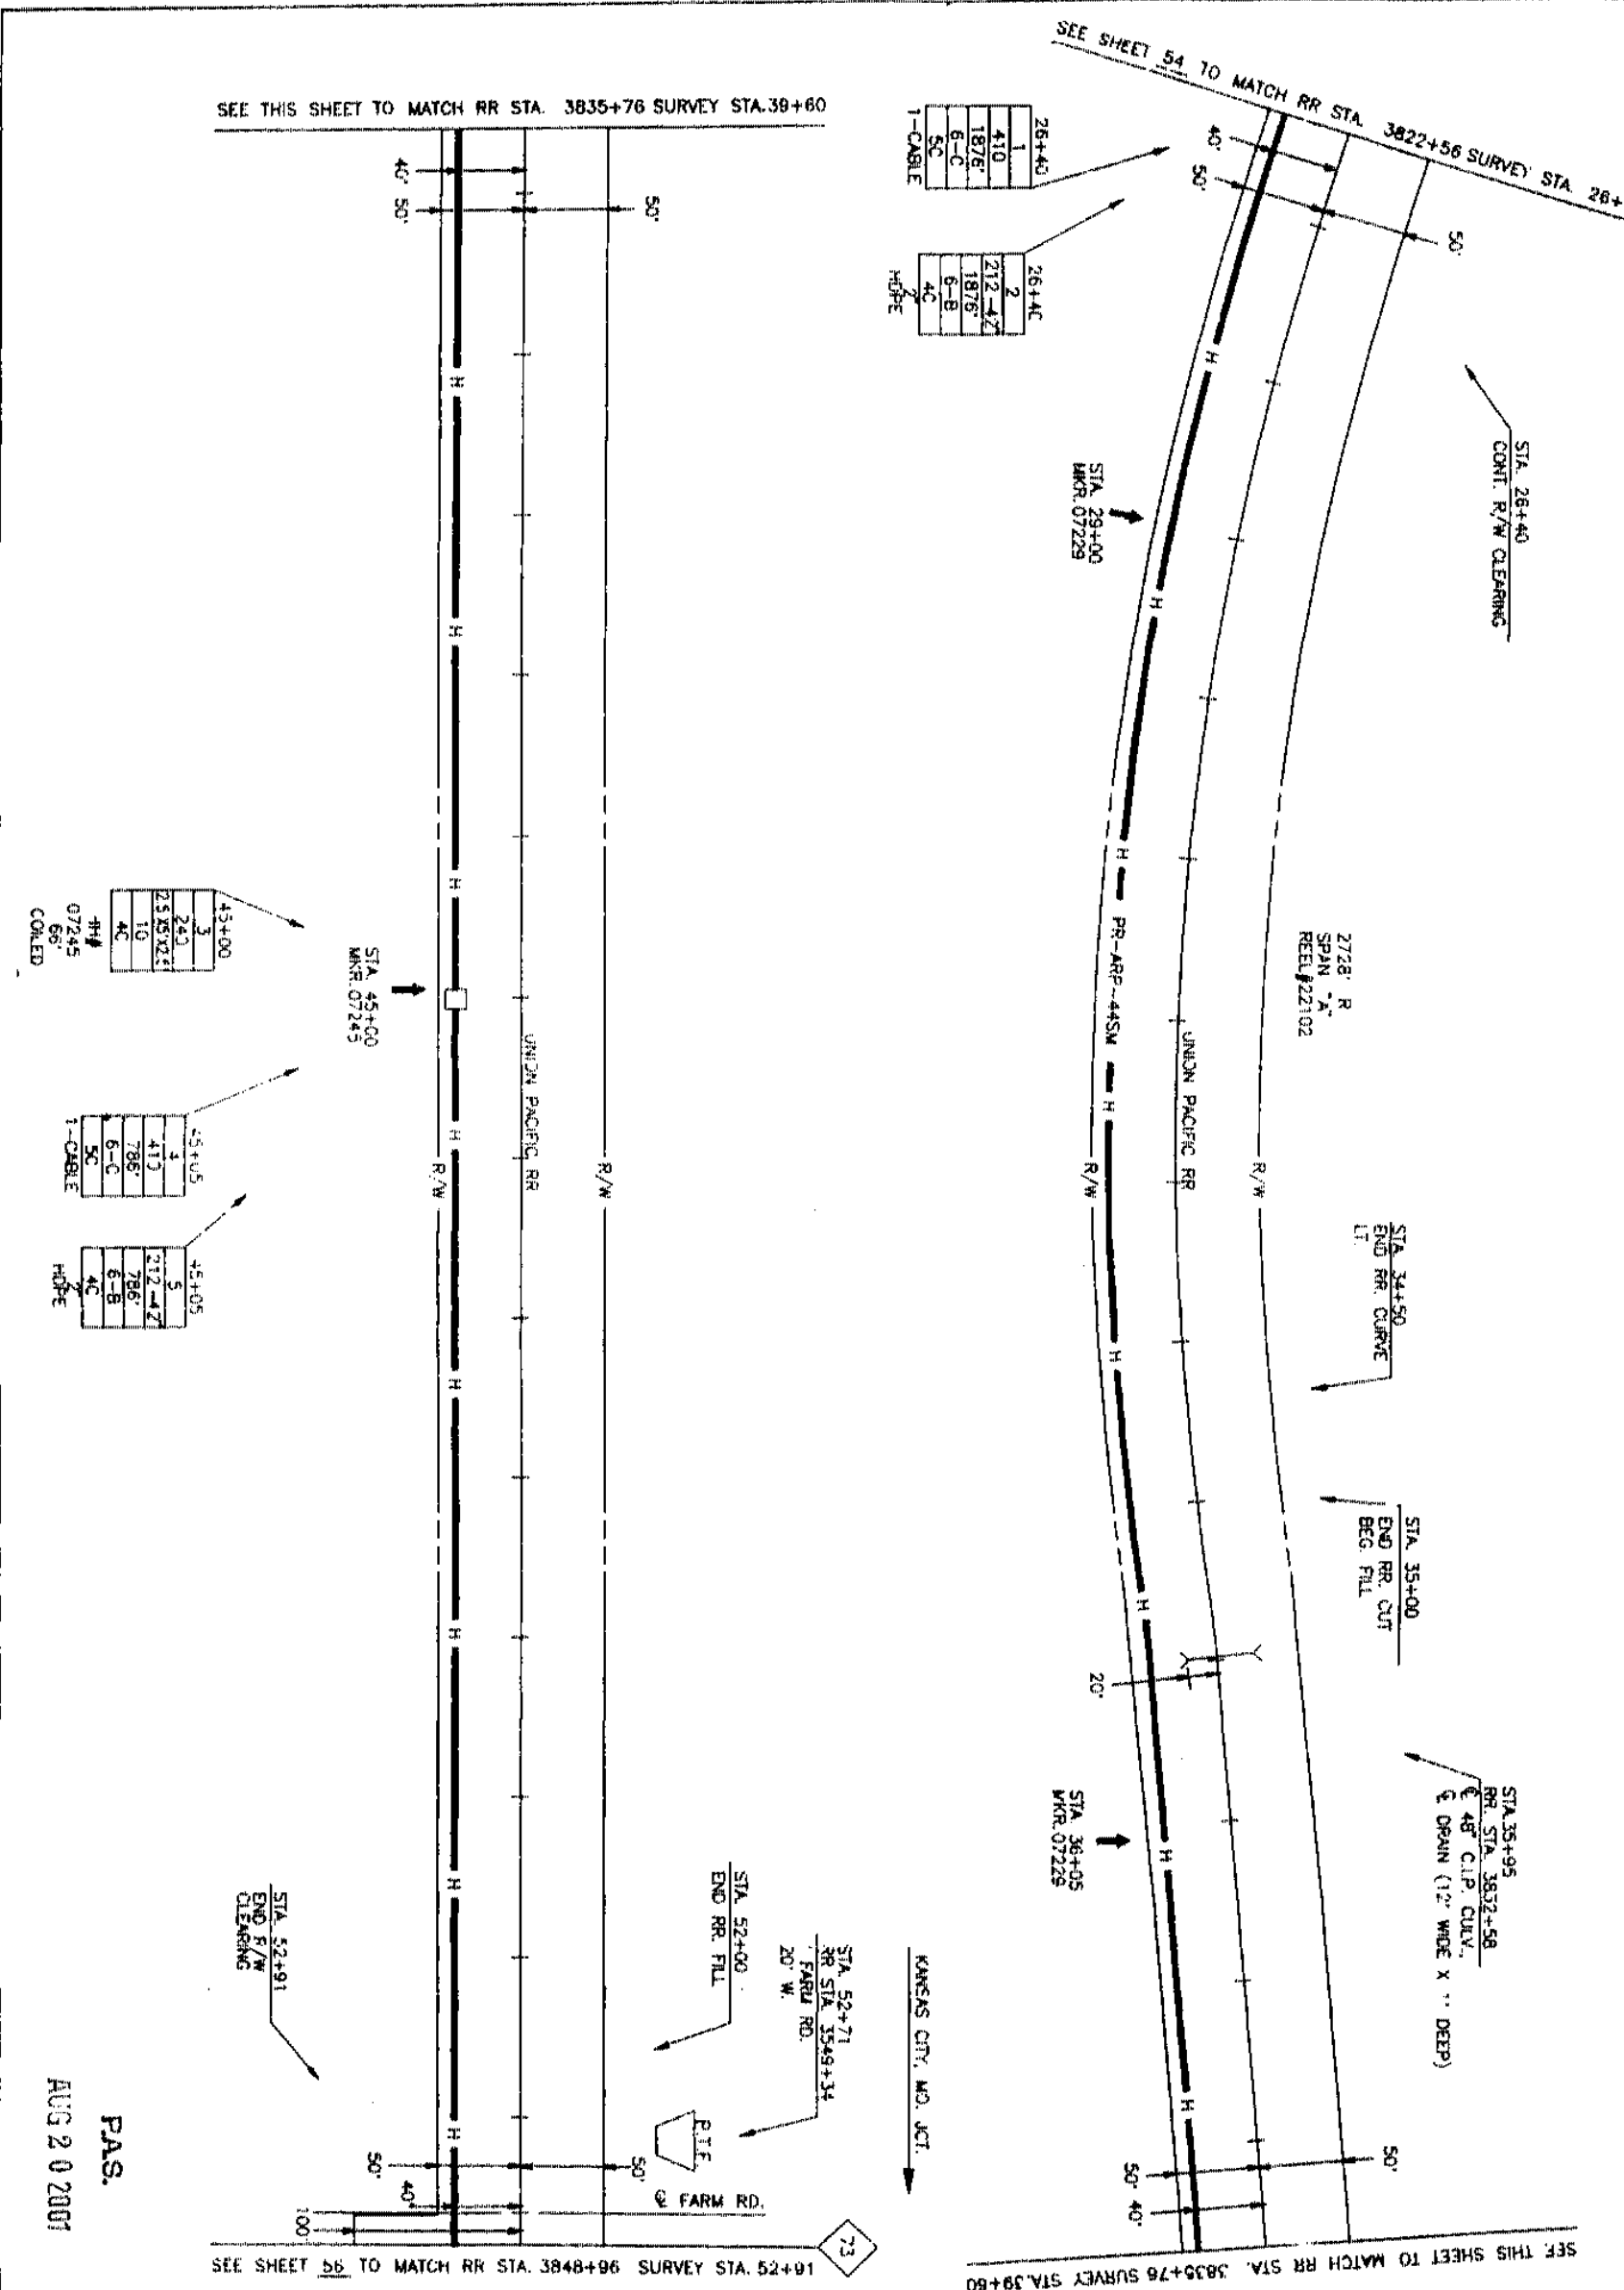

P.A.S.
AUG 2 0 2007

LANCASTER CO., NE.

BUOA TWP.
SEC. 1 & 12, T 7 N - R 6 E

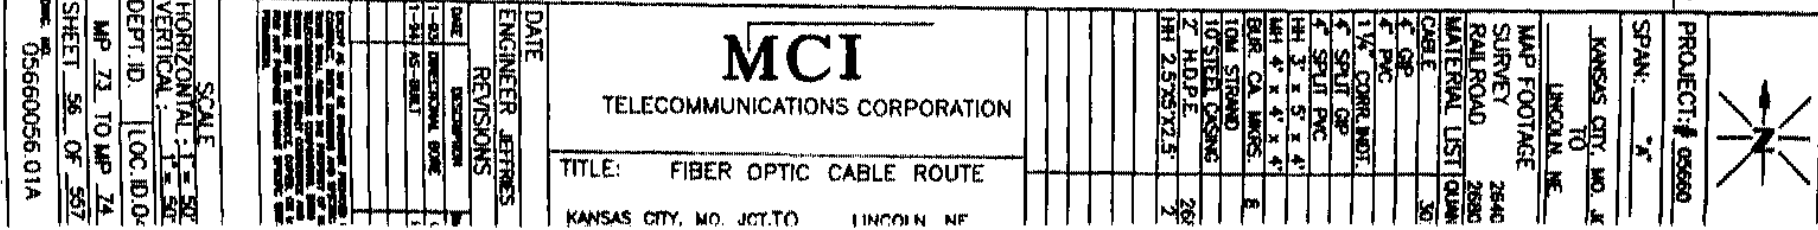

LANCASTER CO., NE.
BUDA TWP.
SEC. 12, T 7 N - R 6 E



SPAN: 1"

LINCOLN, NE.

RAILROAD	2600
----------	------

4 PVC	
-------	--

4	211	PAC
3	211	PAC
2	211	PAC
1	211	PAC

10M STRAND	
10STEEL CASING	

HH 2.5'x5'x2.5'	1
-----------------	---

[illegible]

ATION
TE
E.

COR
LE
NCO

C

THE

FLB

DATE _____

NO	DESCRIPTION	QTY
	CAROLINA	

1	2	3	100
---	---	---	---	---	---	---	---	---	----	----	-----


THE UNIVERSITY OF CHICAGO PRESS

SCALE

SECRET

0566057-01A

SEE THIS SHEET TO MATCH RR STA. 3888+06 SURVEY STA. 40+00

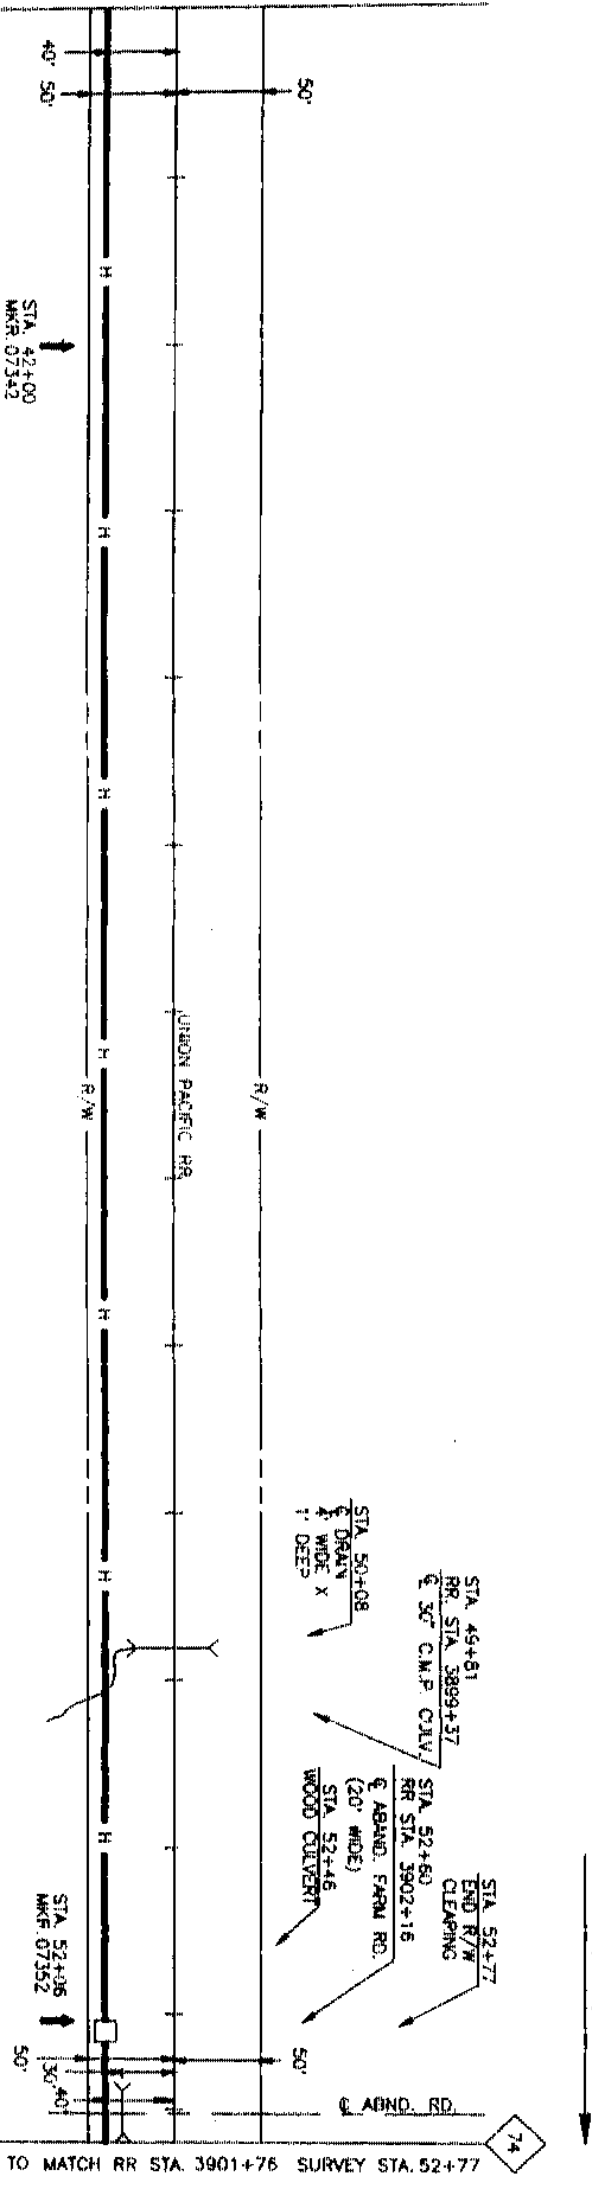

52+06
3
240
27592.5
10
4C
HHH
07352
66
COILED

52+11
4
413
66
6-C
5C
1-CABLE

52+11
5
212-4Z
66
6-B
4C
2
HIDE

SCALE	
HORIZONTAL: 1" = 50'	
VERTICAL: 1" = 50'	
D. LOC. ID. 04	

TITLE: FIBER OPTIC CABLE ROUTE
KANSAS CITY, MO. JCETO LINCOLN, NE.

DATE		ENGINEER		JEFFRIES	
REVISIONS					
DATE	DESCRIPTION	BY	CHK	DATE	DESCRIPTION
1-13	MR STA	C			
1-04	AS-BUILT	F			

C-2000-2, 2000-3, 2000-4, 2000-5, 2000-398, 2

74

LANCASTER CO., NE

SEC. 12 & 13, T 7 N - R 6 E

STA 13+15
RR STA 3915+49
E COUNTY ROAD
OLIVE CREEK ROAD
(D.O.T.#01560398)
19" WIDE GRAVEL
STA 13+24
E.O.G.

PROJECT # 05660
SPAN: A
KANSAS CITY, MO. JCT.
TO
LINCOLN, NE

STA 5+29
RR STA 3907+63
E 48' C.L.P. CULV.

STA 8+00
END R.R. FILL

2707' R
SPAN "A"
REEL #22099

NOTE:
LINCOLN TELE. CO.
BURIED CABLE IN AREA

STA 12+81
END FENCE TEL.
BOX & H-SPOCE

STA 12+96
TIN CULVERT

STA 13+05
E.O.G.

STA 13+24
E.O.G.

STA 13+50
R/W BEG

SEE SHEET 57 TO MATCH RR STA. 3901+76 SURVEY STA. 0+00

SEE THIS SHEET TO MATCH RR STA. 3915+38 SURVEY STA. 13+80

STA 0+00 BEG. 1285' R/W CLEARING	STA 0+00
1	410
2601'	6-C
50	4C
1-CABLE	HOPE

STA 12+85 END R/W CLEARING	STA 13+44 BEG. 1429' R/W CLEARING
12+81	13+02
3	4
210-48'	110-48'
21'	38'
6-A	7-A
4C	4C
W/1-2'	W/1-2'
HOPE & 1'	HOPE & 1'
1' INDOT.	1' INDOT.

STA 13+55	13+55
6	6
212-42'	212-42'
1243'	6-B
4C	4C
HOPE	HOPE

STA 16+00
BEG. R.R.
CLUT AREA

STA 24+00
END R.R.
CLUT AREA

STA 26+00
BEG. R.R.
FILL AREA

KANSAS CITY, MO. JCT.

UNION PACIFIC RR

UNION PACIFIC RR

PR-ARP-44SM

SEE THIS SHEET TO MATCH RR STA. 3913+36 SURVEY STA. 13+80

SEE SHEET 59 TO MATCH RR STA. 3928+16 SURVEY STA. 26+40

25+95	7	240	25922'	10	40'	4C	1-HH #	07426	66'	COILED
26+00	8	410	40'	5C	1-CABLE					
26+00	9	212-42'	40'	6-B	4C					
										2' HOPE

P.A.S.


AUG 20 2001

MCI
TELECOMMUNICATIONS CORPORATION

TITLE: FIBER OPTIC CABLE ROUTE
KANSAS CITY, MO. JUNCTION TO LINCOLN, NE

DATE	ENGINEER	JEFFREY
REVISIONS		
DATE	DESCRIPTION	BY
1-85	RR STA	CL
1-94	65-BEAL	FR

SCALE
HORIZONTAL: 1"=50'
VERTICAL: 1"=50'
DEPT. ID. 10.04
MP 74 TO MP 75
SHEET 58 OF 587
05660058.01A

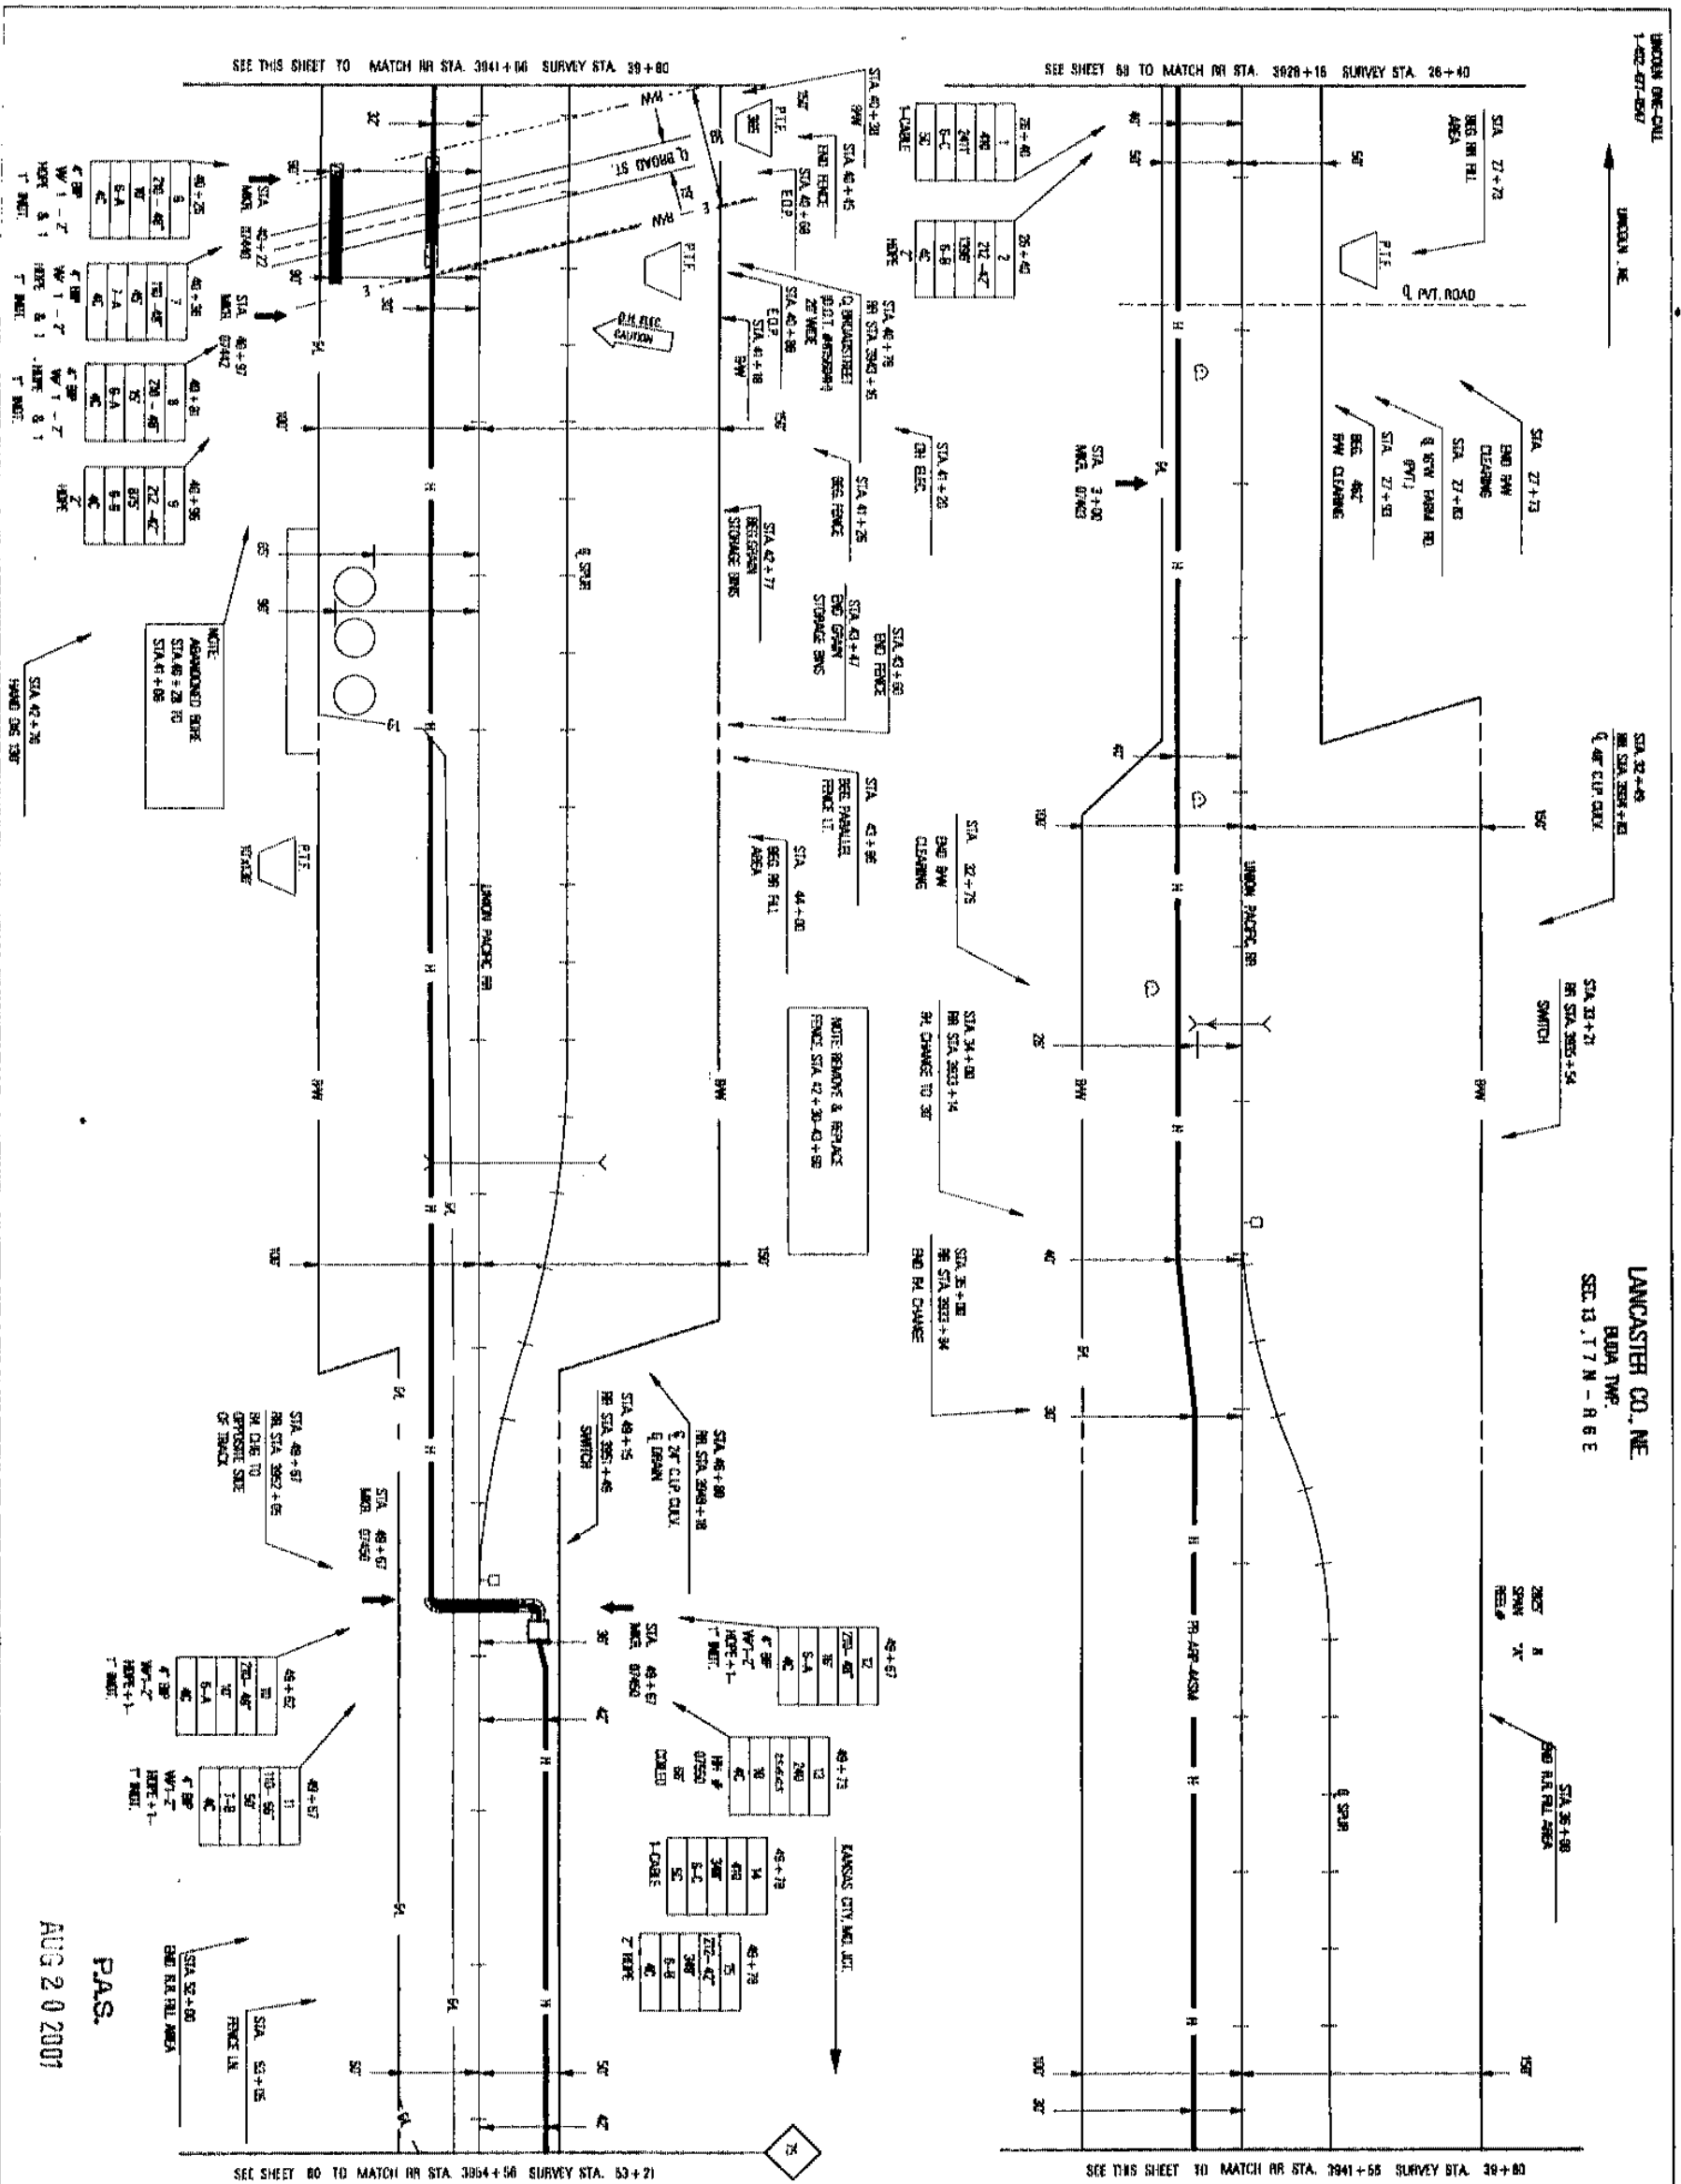


PROJECT: 0500	
SPRINT: A	
KANSAS CITY, MO. JCT. TO LINCOLN, NE	
MAP FOOTAGE: 200' 15'	
SURVEY: 200' 15'	
RAILROAD: 200' 15'	
MATERIAL LIST:	
ITEM	QUANTITY
1. 100' 15'	1
2. 100' 15'	1
SCALE: 1" = 50'	
VERTICAL: 1" = 5'	
DATE: AUG 20 2007	
ENGINEER: P.A.S.	
PROJECT: 0500	
MAP: 7A TO MAP 7B	
SHEET: 50 OF 52	
PROJECT: 0500	

PROJECT: 0500	
SPRINT: A	
KANSAS CITY, MO. JCT. TO LINCOLN, NE	
MAP FOOTAGE: 200' 15'	
SURVEY: 200' 15'	
RAILROAD: 200' 15'	
MATERIAL LIST:	
ITEM	QUANTITY
1. 100' 15'	1
2. 100' 15'	1
3. 100' 15'	1
SEC 23, T7N-R6E

SEC 23, T7N-R6E

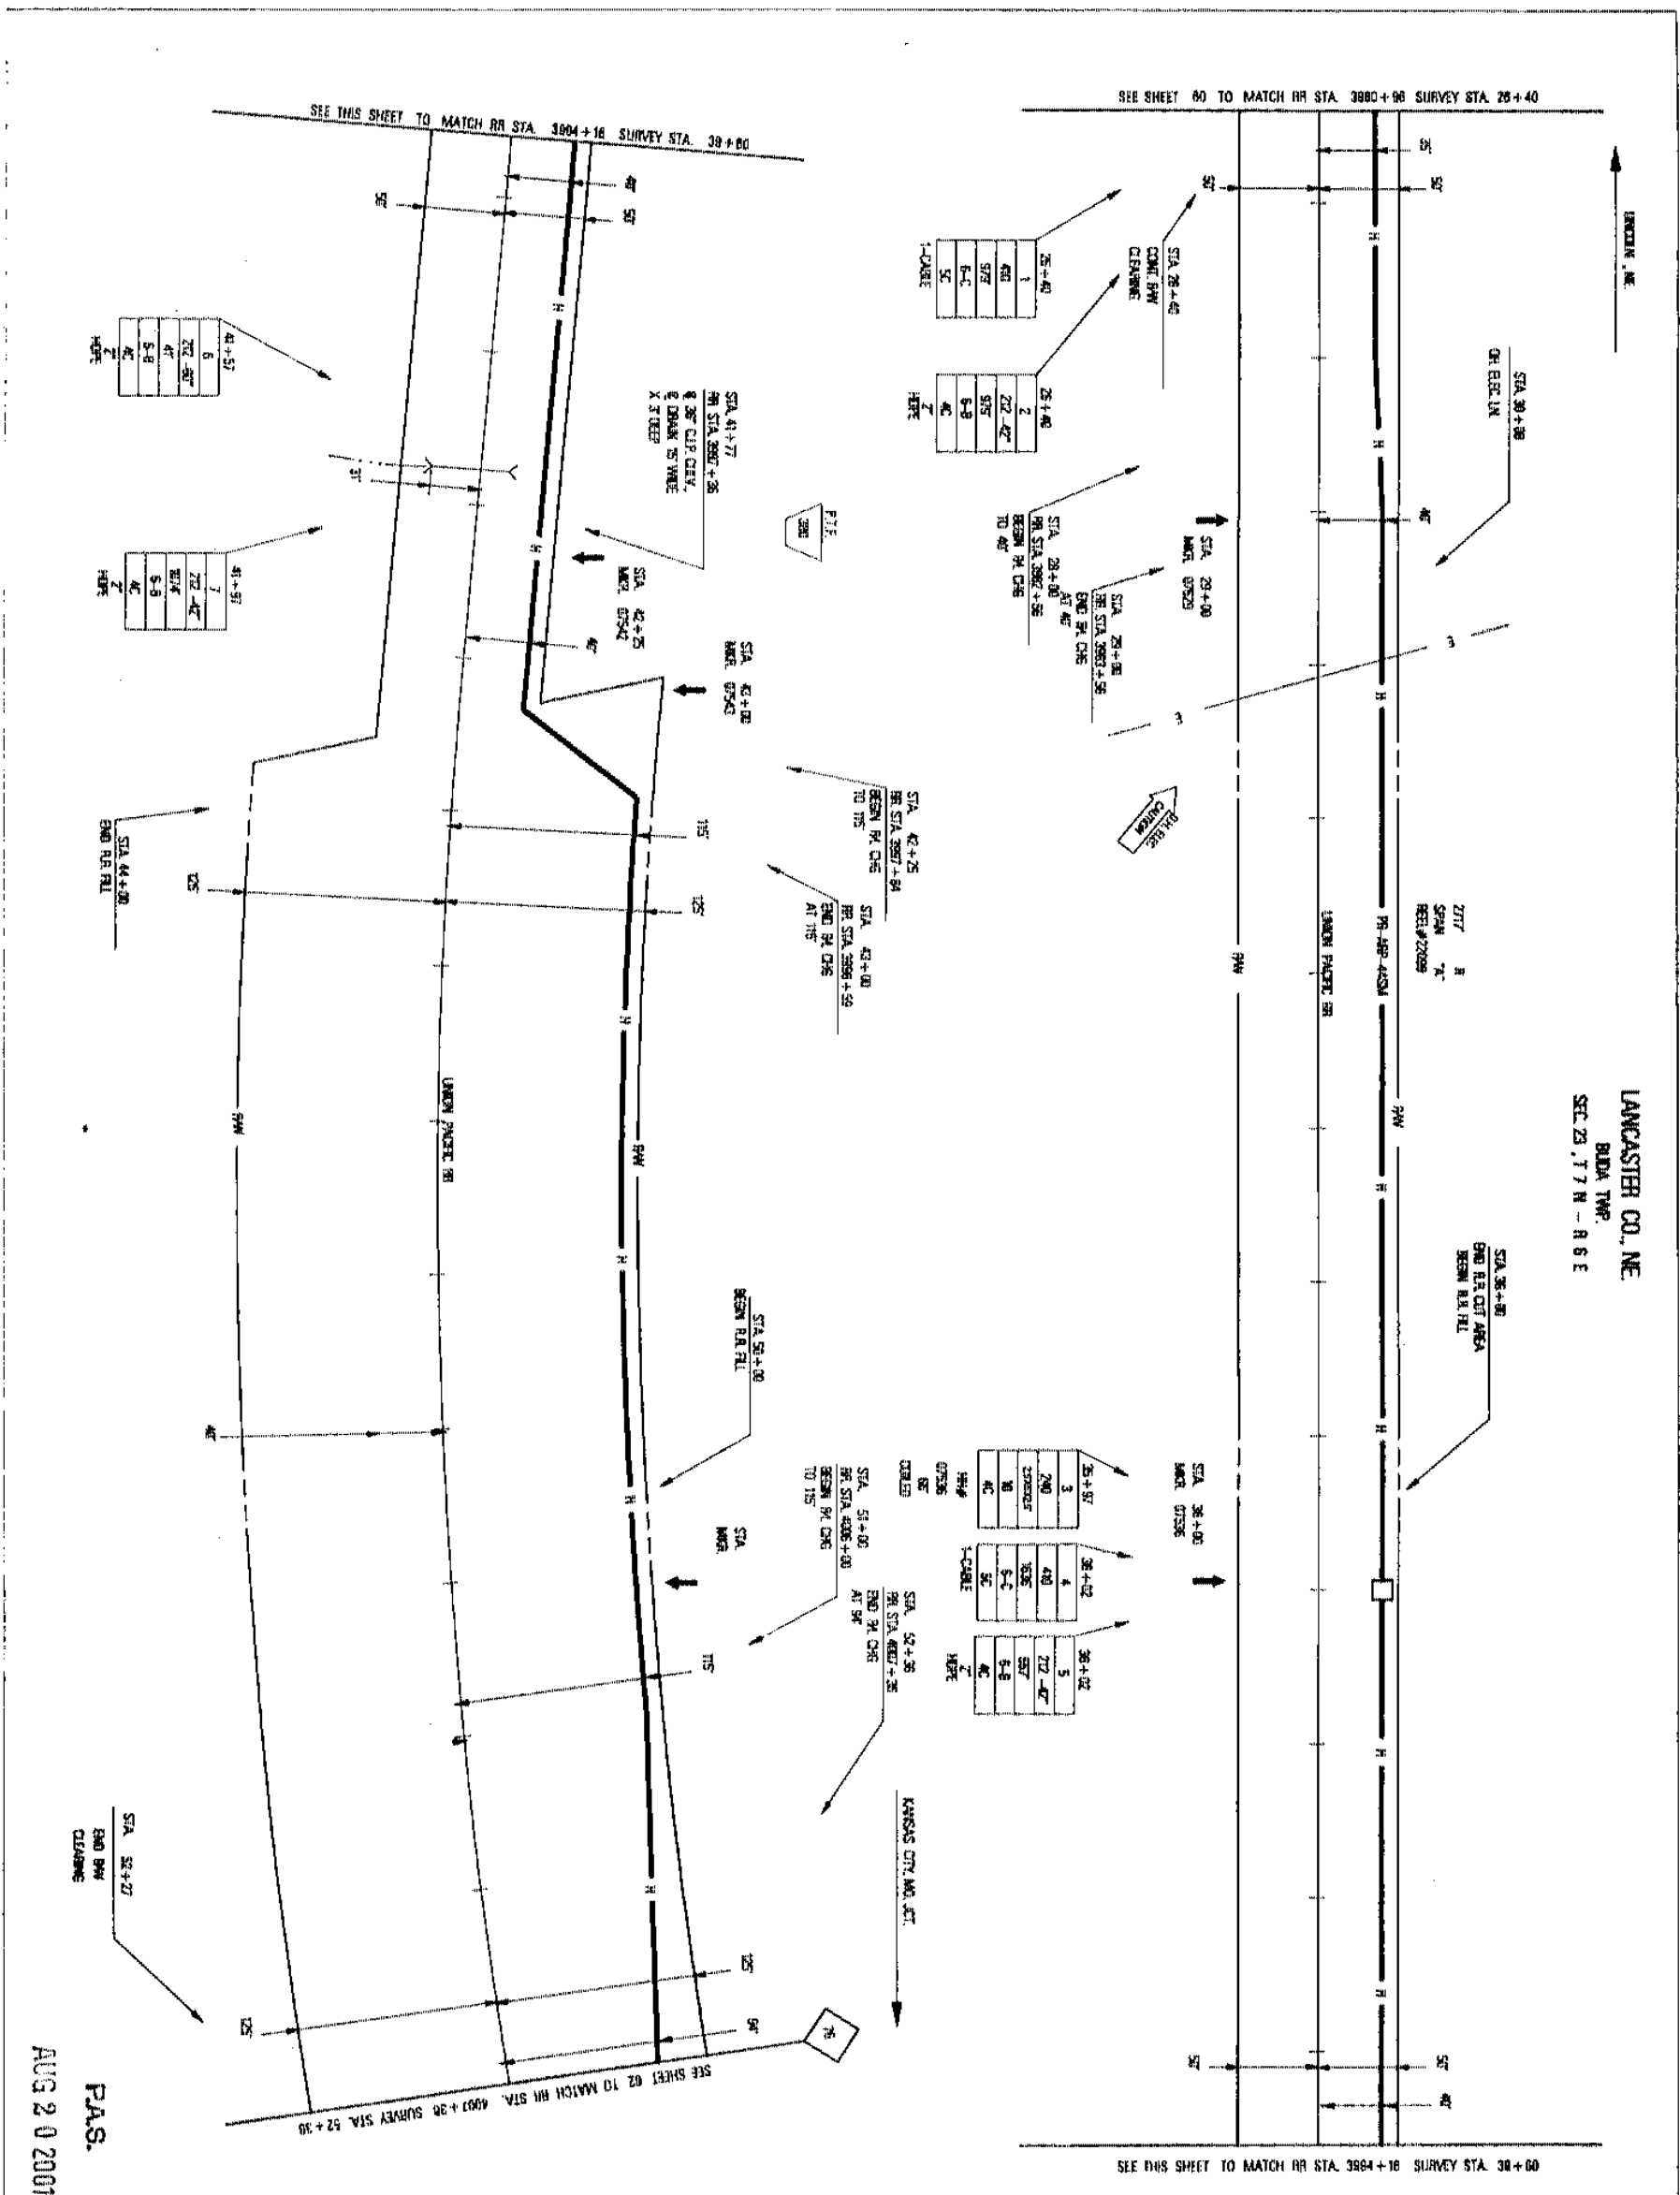

<



PROJECT # 05660
KANSAS CITY, MO. JC
TO
LINCOLN, NE

SPAN: 7' X
2702' R
SPAN 7' X
24' CULVERT NO. 77.17

MAP FOOTAGE
SURVEY 2640'
RAILROAD 2640'
MATERIAL LIST (QUAN)

CABLE
11/4" CORR. MGT.
4" GP
4" SPLIT GP
1/4" X 3' X 4'
1/4" X 1' X 4'
BUR. CA. MKRS. 5
10M STRAND
10 STEEL CASSING
1H 2.5' X 5' X 2.5' 1
2 HOPE 2357
3 1/2" BIP 249
1" MGT.


DATE
ENGINEER
REVISIONS
DATE DESCRIPTION
1-83 RR STA
1-84 AS-BUILT
1-84




TITLE: FIBER OPTIC CABLE ROUTE
KANSAS CITY, MO. JCT. TO LINCOLN, NE

SCALE
HORIZONTAL: 1"=50'
VERTICAL: 1"=50'
DEPT. ID. LOC. ID. 04
MP 77 TO MP 78
SHEET 64 OF 597
Dwg. No. 05660064.01A

LANCASTER CO., NE.
BUDA TWP.
SEC. 26, T7N, R6E

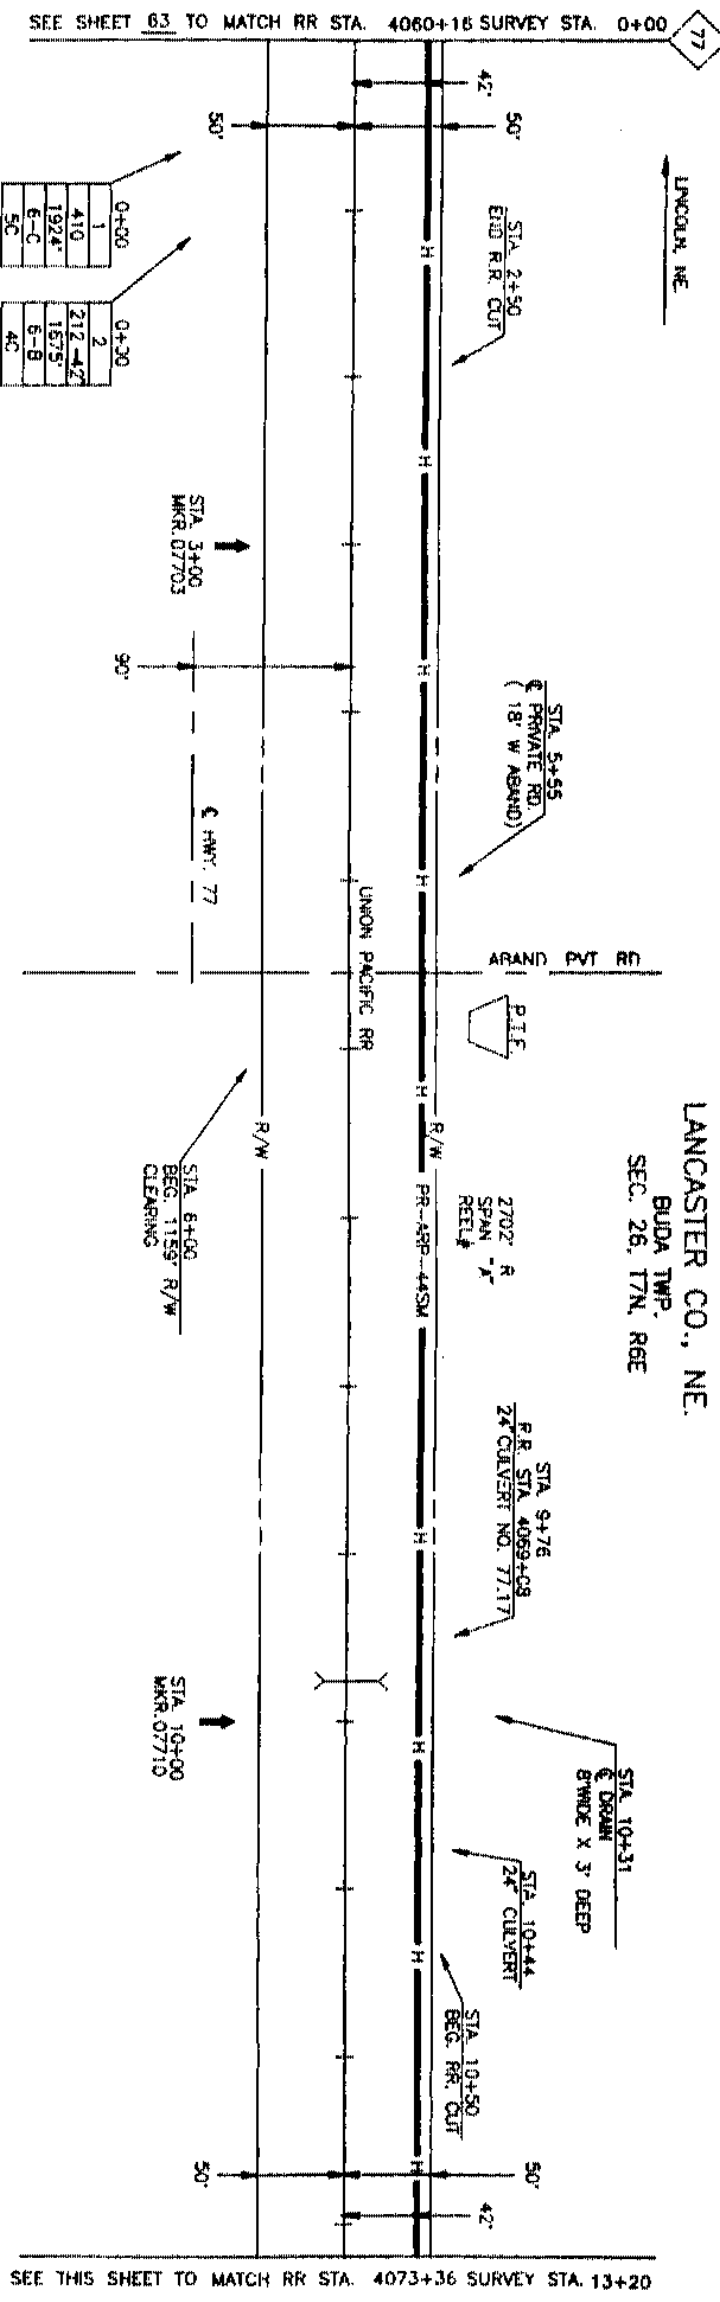

SEE SHEET 63 TO MATCH RR STA. 4060+16 SURVEY STA. 0+00

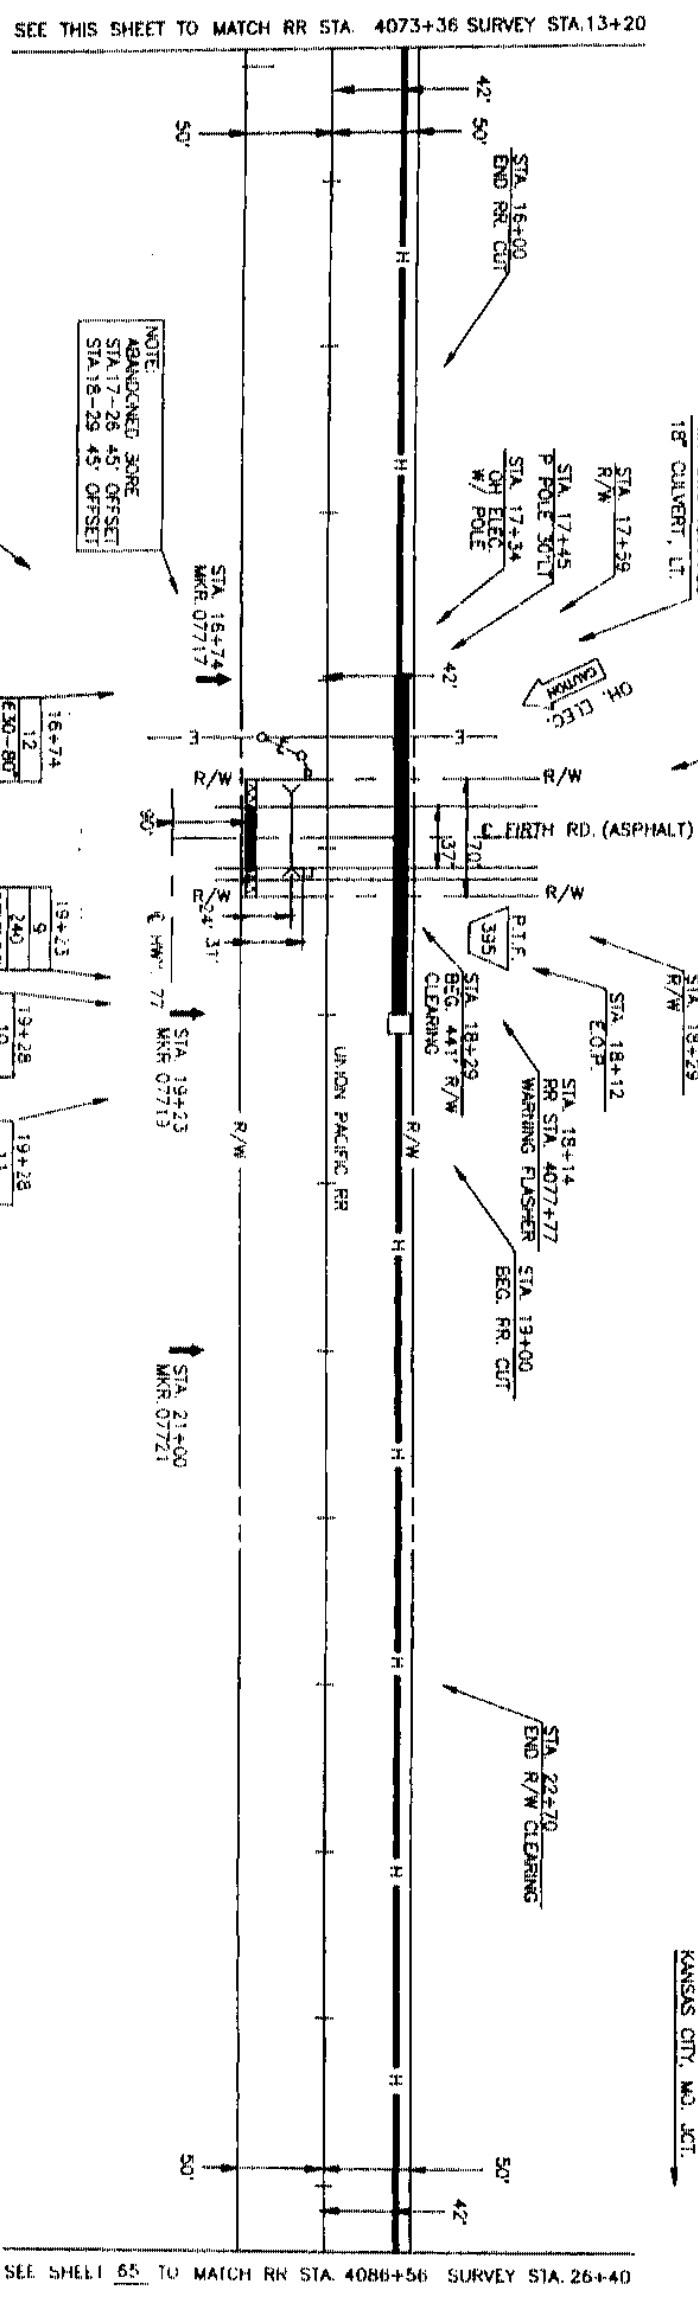

SEE THIS SHEET TO MATCH RR STA. 4073+36 SURVEY STA. 13+20

P.A.S.
AUG 20 2007



LANCASTER CO., NE
BUDA TWP.
SEC. 35, T 7 N, R. 6 E

2714' R
SPAN "A"
REEL# 22058

SEE SHEET 64 TO MATCH RR STA. 4085+56 SURVEY STA. 26+40

SEE THIS SHEET TO MATCH RR STA. 4099+76 SURVEY STA. 39+80

1	2
410	212-42
2454	2454
6-C	6-B
5C	4C

1-CABLE

HDPE

2
212-42
2454'
6-B
4C
NDPE

STA 43+98
Sta 4103+61
BATTERY BOX

KANSAS CITY, MO. JCT.

SEE THIS SHEET TO MATCH RR STA. 4099+76 SURVEY STA. 39+80

SEE SHEET 66 TO MATCH RR STA. 4112+96 SURVEY STA. 52+95

STA. 47+00
R. 077+1


ST.A. 51+00
MKR. 07751

5	4	5
240	410	212-42
22578723	194	194
10	6-C	6-B
4C	5C	4C
	1-CABLE	7
		HOPE

045

REV 2001


[illegible]

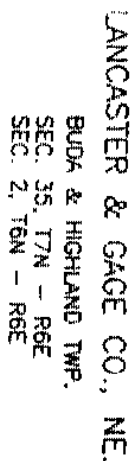

BUDA & HIGHLAND TWP.
SEC. 35, T7N - R6E
SEC. 2, T6N - R6E

LANCASTER & GAGE CO., NE.

LINCOLN, NE

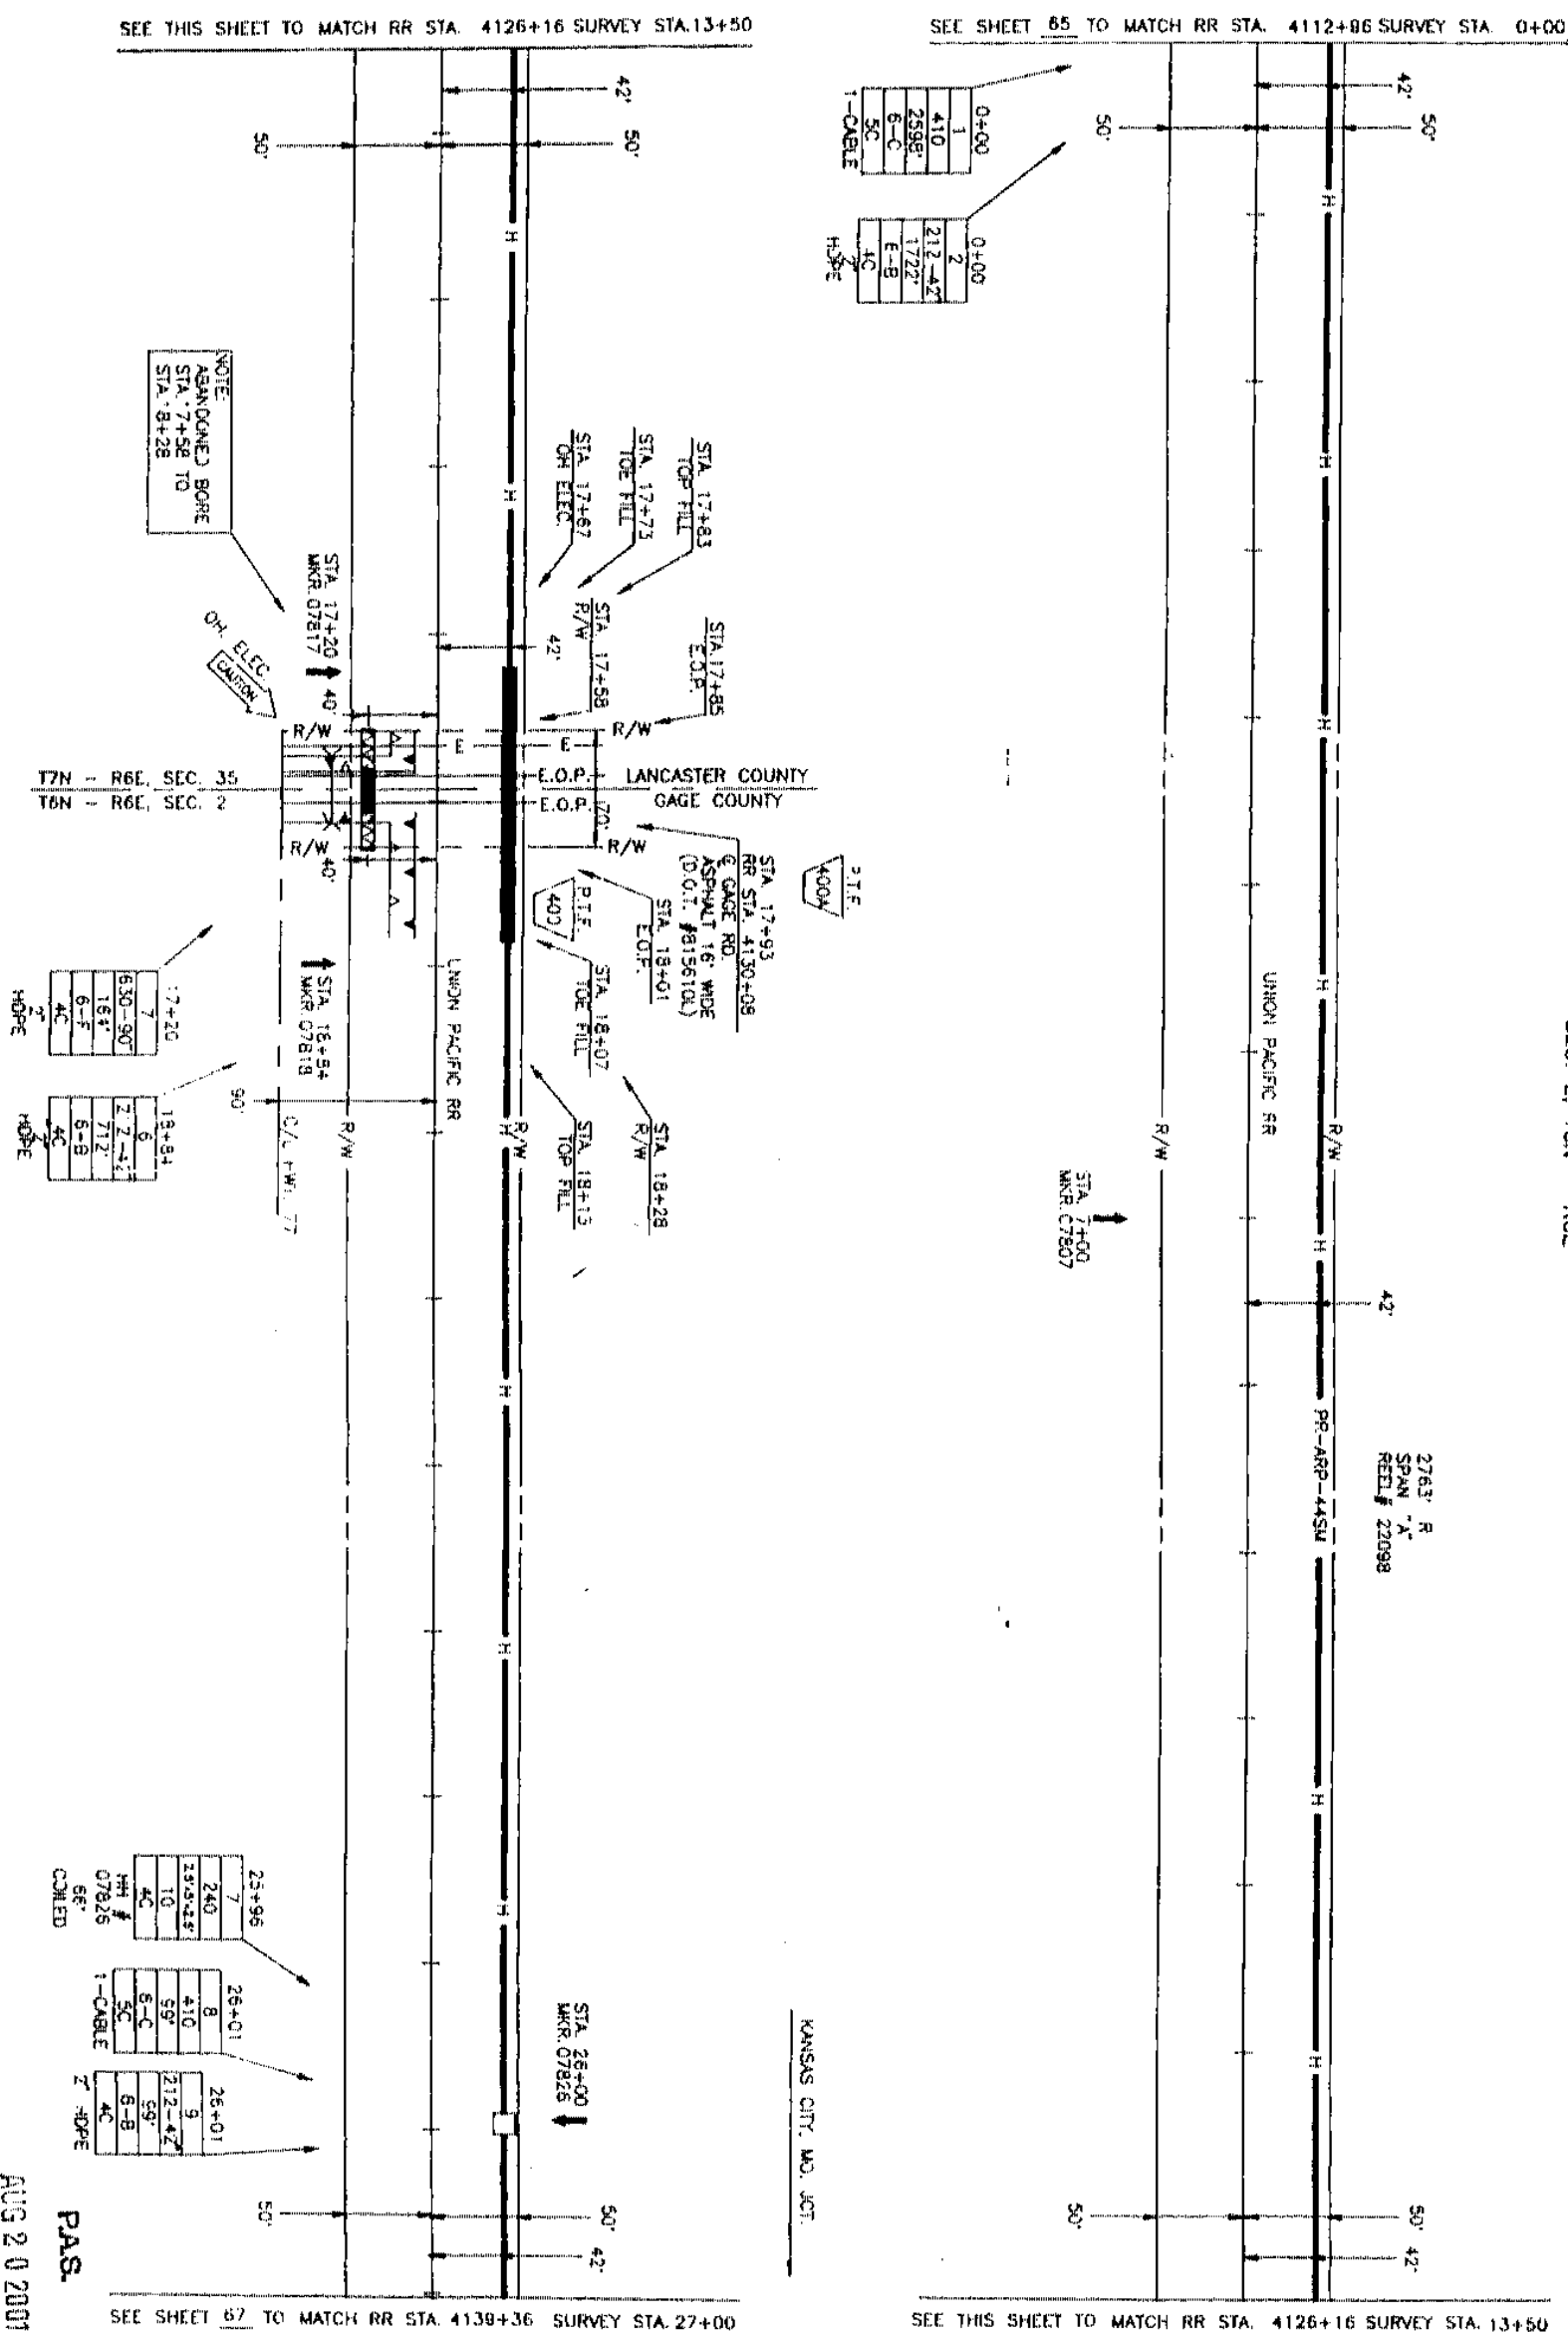

PAS

AUG 20 2001

PROJECT # 00560	
SPAN: "A"	
TO KANSAS CITY, MO. & LINCOLN, NE.	
MAP FOOTAGE	
SURVEY	2700
RAILROAD	2540
MATERIAL LIST	QUANTITY
CABLE	2735
4" GP	
4" PVC	
11" CORR. JT	
4" SPLIT GR-4	
4" SPLIT PVC	
HH 3" x 5" x 4"	
HH 4" x 4" x 4"	
BLR CA. MKRS.	4
10M STRAND	
10 STEEL CLOSING	
HH 2.5" x 2.5"	1
1" ROD	
2" HOPE	2635
4" BIP	
DATE	
ENGINEER	
REVISIONS	
DATE	DESCRIPTION
1-83	RR STA
1-84	AS-BUILT
SCALE HORIZONTAL: 1"=50' VERTICAL: 1"=50' DEPT. ID. LOC. ID. 0-1 MP 78 TO MP 79 SHEET 66 OF 557 05600066.01A	