Note: The South Line of Lot 23 has been changed to 93' in lieu of 85'. Date: 16 May 1957.
The above change made by Willis Foster
City Engineer
Bellevue Nebr.
Witnessed By F. L. Waltz
County Surveyor
Sarpy County
Nebr.

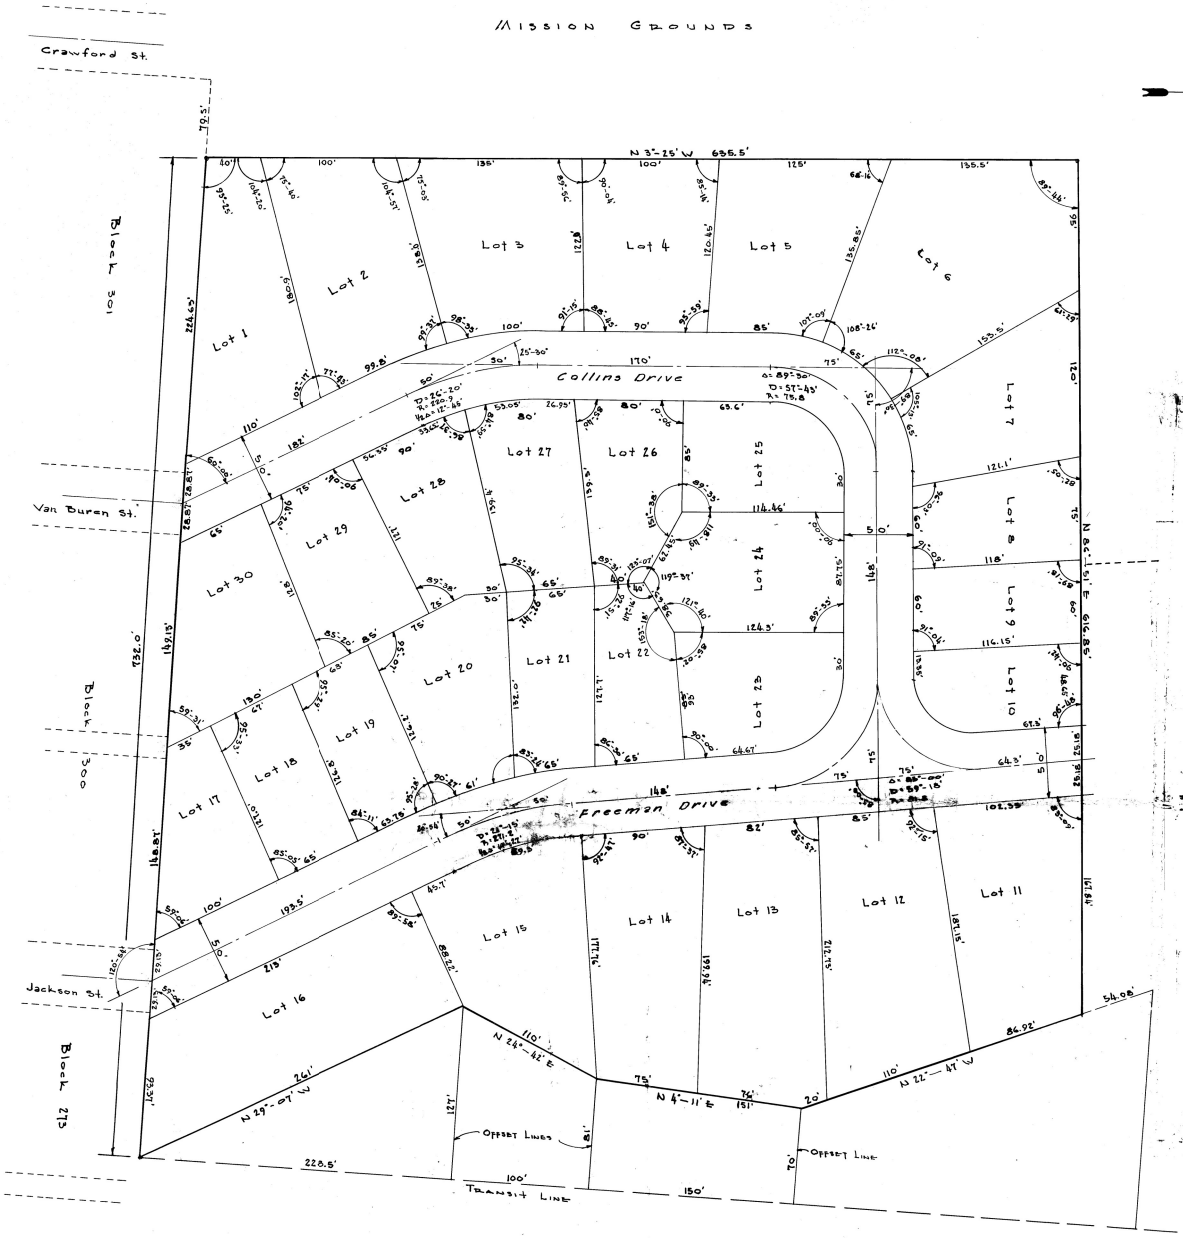

Surveyors Certificate

This is to certify that I have accurately surveyed and set iron points on all lot corners, in Mission Heights Addition "A", an addition to the City Of Bellevue Nebr., as laid out by me on a tract of land lying wholly within the South portion of tax lot 2A1, which lays wholly in the West ½ of Section 36 Township 14 North, Range 13 East of the 6th P.M., all in Sarpy County Nebr. More particularly described as follows: Referring to the South-East corner of tax lot 2A1 as the point of beginning, thence west 732.0 feet, thence north 3°-25' west a distance of 635.5 feet, thence north 86°-51' east a distance of 616.85 feet, thence south 22°-47' east a distance of 216.92 feet, thence south 4°-11' west a distance of 151.0 feet, thence South 24°-42' west a distance of 110.0 feet, thence south 29°-07' east a distance of 261.0 feet to the point of beginning, containing 9.8 Acres more or less all in Sarpy County Nebr.

Dated this 22 day of July 1954
By W. J. Neumarker
William Neumarker

Dedication

Know all men by these present, that we George F. Rushart President, F. Hoyte Freeman Treasurer, & Gerald E. Collins Secretary, of Bellevue and Omaha Nebr. Incorporators of Mission Homes Inc., proprietors of the property described in the Surveyors Certificate and embraced in this Plat, have caused said tract of land to be Platted as shown and to be hereafter known as Mission Heights Addition "A", do hereby dedicate to the Public, For Public use, the streets as shown on said Plat and so do hereby state that the above Subdivision of the property described in the Surveyors Certificate as appears on this Plat, is made with free consent and in accordance with the desire of the undersigned proprietors of Mission Homes Inc.

By: George F. Rushart
George F. Rushart Pres.
F. Hoyte Freeman
F. Hoyte Freeman Treas.
Gerald E. Collins
Gerald E. Collins Sec.

Seal of Mission Homes Inc.

State of Nebraska
County of Sarpy
On this 23 day of July A.D. 1954, before me, a Notary Public duly commisioned and qualified and for said County, personally came the above named George F. Rushart Pres., F. Hoyte Freeman Treas., & Gerald E. Collins Sec. who are personally known to me to be the identical persons whose names are affixed to the above dedication to be thier voluntary act and deed, of said Mission Homes Inc.
Witness my hand and official seal at Bellevue in said County, the date last aforesaid
Clarence W. Otto
Notary Public

My commision expires on the 6 day of April A.D. 1958

Acceptance By The City Council of Bellevue, Nebraska

This Plat of Mission Heights Addition "A" was approved and accepted by the City Council of the City of Bellevue, Sarpy County, Nebraska.

Attest: Mary Stricklett
City Clerk

Joe Morgan
Joe Morgan, Mayor

County Treasurers Certificate

I hereby certify that the records of my office show no taxes due or delinquent upon the property described in the Surveyors Certificate in the Plat, as of A.D. 1954

Robert M. Eby
County Treasurer
Sarpy County, Nebraska.

Mission Heights Addition "A" Mission Homes Inc.		
For Annexation		
Drawn: RS Scale: 1" = 40'	City of Bellevue Sarpy County Nebraska	Surveyed: NW. NW. NE. RS. N.W. Date: 22 July 1954

Filed 8-3-54

P.40